IREDELL COUNTY HEALTH DEPARTMENT

STATESVILLE 704-878-5305 (ad 1-23-09) MOORESVILLE 704-664-5281

IMPROVEMENT PERMIT / AUTHORIZATION TO CONSTRUCT / OPERATION PERMIT / EXISTING SYSTEM INSPECTION

PERMIT# 13403 PIN# 4739396027 DATE 3-2-06

OWNER OR CONTRACTOR Ronald H Cornell PHONE: Business Home 607-279-0492

ADDRESS 197 Cortland McLean RD - RD 2 Cortland NY 13045

LOCATION 175 North Right on Sivers Creek Left on N Chipley 3 on Dexter rd, lot

SUBDIVISION BLOCK / SECTION LOT LOT AREA 5.526 SITE CLASS PS DESIGN FLOW 480 L.T.A.R. .3

Septic Tank: 1000 Gallons; STB Date 3-2006

Pump Tank: Gallons; PT Date

Pump Make: Model Serial No.

Nitrification Field: No Fields Square Feet 1600 Linear Feet 400

No Lines 5 Trench Width 36 Max Trench Bottom Depth 36" Gravel Depth

☐ New System ☐ Repair System Type: I, II, III, IV, V, VI

System Description: Gravity 25%

Repair System Description: Gravity 25%

Maintenance Agreement Required: ☐ Yes ☐ No

☐ House/Mod. Home No. Bedrooms 4

☐ Mobile Home No. Bathrooms

☐ Business No. Employees

☐ Other

☐ Slab ☐ Crawl Space ☑ Basement w/plumbing ☐ Basement wo/plumbing

Water Supply: ☐ Individual ☐ Public ☐ Community


Comments:/Conditions:

Well Must be 100' away Septic and Repair area.

Comments:/Conditions:

Install on contour maintain all setbacks

INITIAL SITE SKETCH

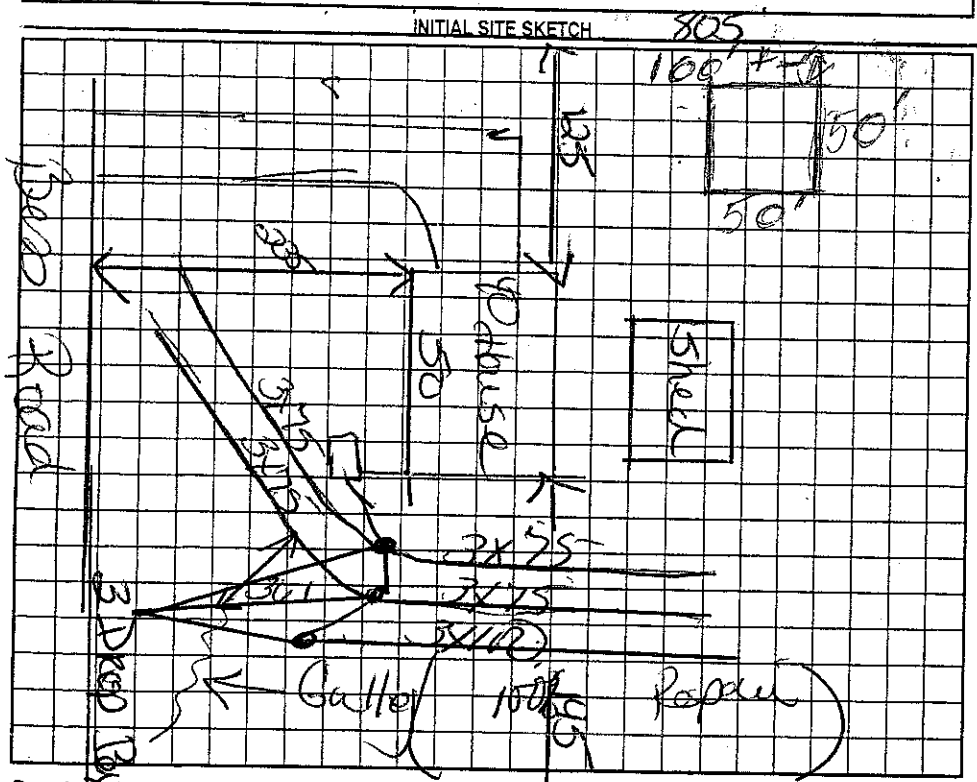

AS BUILT SKETCH

(Not to Scale)

Red Polylock Septic tank made

The proposed / existing Shed addition does not appear to impact the existing septic system.

**NOTE:

R.S.

Date: 11-24-09

ICHD-Environmental Health Division

Permit can be suspended or revoked if any false information is supplied toward securing the permit/any unauthorized changes are made to the site/any unauthorized changes are made in the installation of the system. Improvement Permit with plat valid without expiration. Improvement Permit with site plan valid for sixty months. Authorization to Construct is valid for a period equal to that of Improvement Permit – not to exceed sixty months.

Signed: Ronald H Cornell date

Improvement Permit by: Kelly Cook date 3-2-06

Authorization to Construct by: Kelly Cook date 8-5-06

Installed by: Ronald Cornell (Homeowner)

Operation Permit by: Kelly Cook date 11-11-09

Existing System Inspection by: date

HEALTH DEPT. COPY: WHITE OWNER COPY (FINAL): YELLOW OWNER COPY (INITIAL): PINK