10-0

IREDELL COUNTY HEALTH DEPARTMENT

STATESVILLE 704-878-5305 MOORESVILLE 704-664-5281

IMPROVEMENT PERMIT / AUTHORIZATION TO CONSTRUCT / OPERATION PERMIT / EXISTING SYSTEM INSPECTION

PERMIT # 159682 PIN # 4739396389 DATE 3-22-10

OWNER or APPLICANT Darren Campbell PHONE: Business Home: 704 876 2702

OWNER or APPLICANT ADDRESS 4118 Wilkesboro Hwy Statesville NC 28625

LOCATION / DIRECTIONS 115 N @ Hems Grove @ Chipley Ford @ BESS on Left 300 yds by creek

SUBDIVISION BLOCK / SECTION LOT # LOT AREA 6.10 Acres DESIGN FLOW 480 L.T.A.R. .3

Septic Tank 1000 Gallons: STB 760 Date 10-24-09

Pump Tank Gallons: P T Date

Pump Make Model Serial #

Nitrification Field No Fields 1 No Lines 4 Linear Feet 400'

Trench Width 36" Max. Trench Bottom Depth 36" Gravel Depth N/A

☒ New System ☐ Repair ☐ Expansion System Type I II (III) IV V VI

System Description: GRAVITY 25% REDUCTION

Repair System Description: GRAVITY CONV

Maintenance Agreement Required ☐ YES ☒ NO

☒ GRAVITY ☐ PRESSURE

☒ Residence No. Bedrooms 4

☐ Business No. Persons 5

☐ Other No. Employees

☐ Slab ☒ Crawl Space


☐ Basement w/plumbing ☐ Basement w/o plumbing

Water Supply: ☒ Private ☐ Public ☐ Community


Comments / Conditions ① Install Lines on contours maintain setbacks. ② System & House FLAGGED OUT completely ③ Owner REQUEST 25% REDUCTION system

Comments / Conditions * ONLY Putting a 3 bedroom home on the property, System sized for 4 bedroom for future bedroom expansion.

INITIAL SITE SKETCH

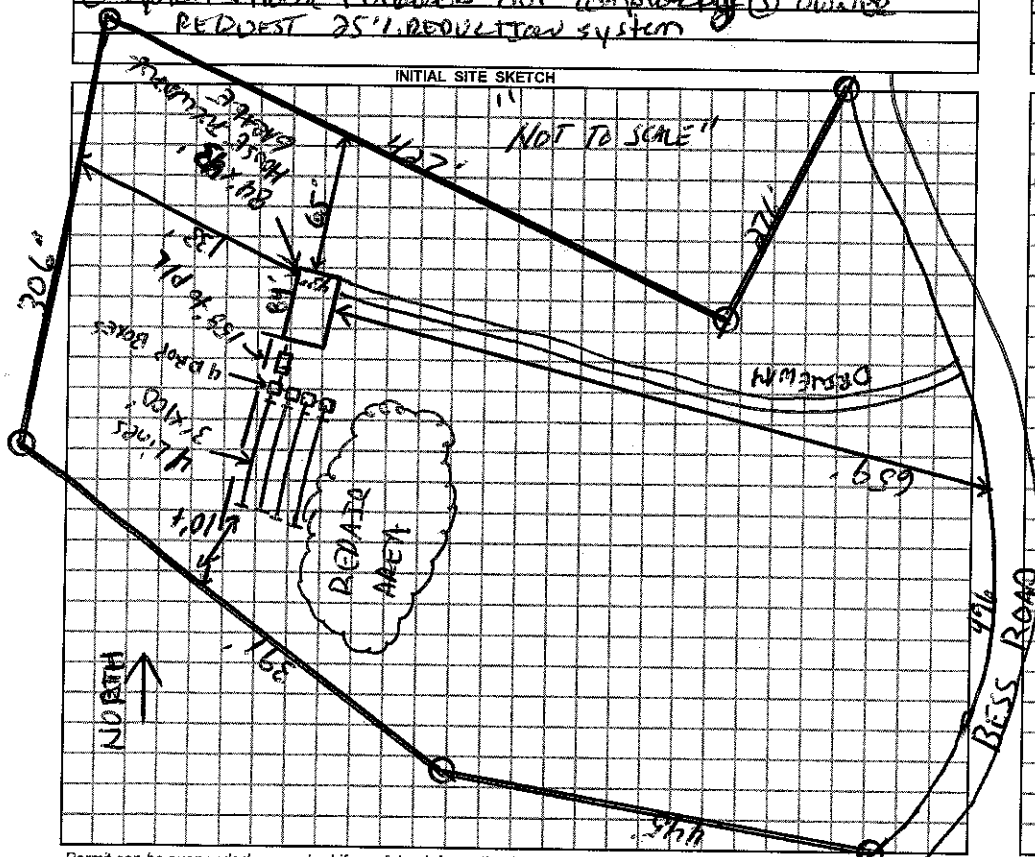

AS BUILT SKETCH

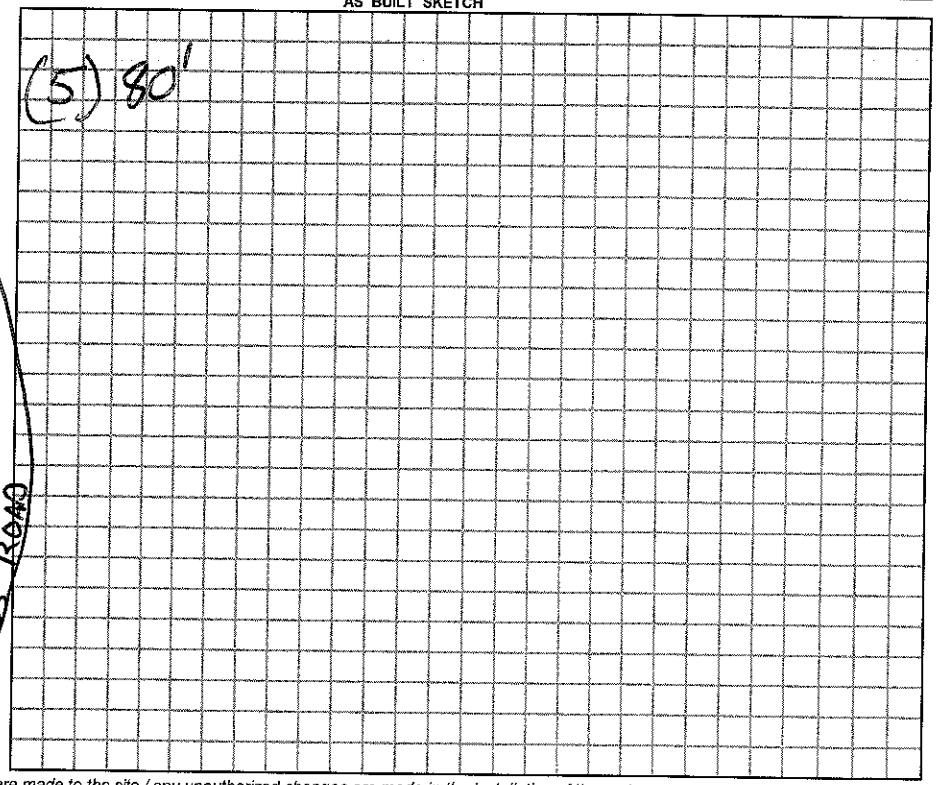

Permit can be suspended or revoked if any false information is supplied toward securing the permit / any unauthorized changes are made to the site / any unauthorized changes are made in the installation of the system.

☐ IMPROVEMENT PERMIT w / plat valid without expiration. ☐ IMPROVEMENT PERMIT w / site plan valid for 60 mos.

☒ AUTHORIZATION TO CONSTRUCT valid for period equal to IMPROVEMENT PERMIT-not to exceed 60 mo.

Owner / Applicant Signature: Date 3-22-10

Improvement Permit by: Date 3-22-10

Authorization to Construct by: Date 3-22-10

Installed by: Backhoe

Operation Permit by: Date: 5-5-10

Existing System Inspected by: Date:

YOU SHOULD CONTACT A LOCATOR SERVICE PRIOR TO ANY EXCAVATION.

WHITE COPY Environmental Health YELLOW COPY (Final) Owner / Applicant PINK COPY (Initial) Owner / Applicant