IREDELL COUNTY HEALTH DEPARTMENT

Statesville Phone TR 3-7271 . Mooresville Phone No. 664-5281

PERMIT TO INSTALL SEPTIC TANK

Permit No. _____ Permit Date 10-15 1973

Owner Clarence Pitts (Michael Pitts) Address Statesville N.C.

Installed By Roy Leatz & Clarence Pitts Address Statesville NC


Location of Property Out Chipley Ford Rd.
Last Trailer on L. Before Snow Creek Rd.

Tank		Capacity		Length of Lines		Fixtures	
Block	(✓)	1000	(✓)	225'	(✓)	No. of Baths	( )
Precast	( )	1250	( )	250'	( )	Dishwasher	( )
		1500	( )	Other_____		Garbage Grdr.	( )
		Other_____				Other_____	

NOTIFY HEALTH DEPARTMENT AT LEAST EIGHT HOURS BEFORE TANK IS TO BE INSPECTED.

Final Inspection 10-15 1973 Approved (✓) Disapproved ( )

Remarks Water from across Road

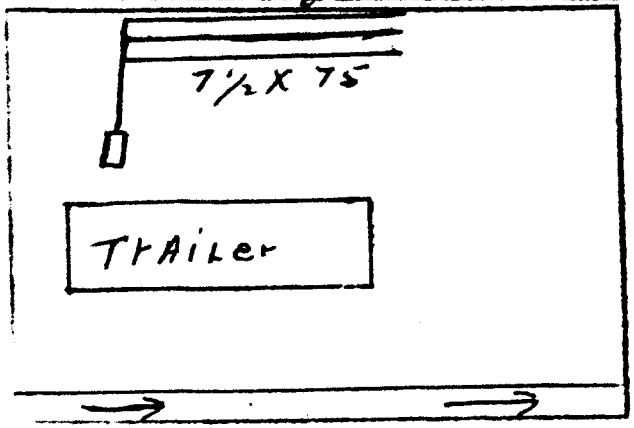

Sketch of Installation

Block Tank Was already Covered. Lines O.K.

E. A. Stevenson
Sanitarian