48/91

IREDELL COUNTY HEALTH DEPARTMENT

STATESVILLE 704-878-5305 MOORESVILLE 704-664-5281

IMPROVEMENT PERMIT / CERTIFICATE OF COMPLETION / OPERATION PERMIT / EXISTING SYSTEM INSPECTION

PROPERTY DESCRIPTION NO. 16716 DATE 7/28/93 TAX MAP NO. 13F-A-3

OWNER OR CONTRACTOR DENNIS M. LEAK PHONE: Business Home 873-1503

ADDRESS 409 S. RACE ST. STVL, NC, 28677

LOCATION NC 115 N, TR 3 CHIPLEY FORD RD, TL SNOW CREEK RD, 100 YARDS W (E)

SUBDIVISION BLOCK / SECTION LOT LOT AREA 19.6 AC SITE CLASS B L.T.A.R. 0.35 GPD/FT2

Water Supply: ☑ Individual ☐ Community ☐ Public WELL

Septic Tank: 1500 Gallons: STB 1011 Date 8/19/93

Pump Tank: Gallons: PT Date

Nitrification Field: No. Fields 1 Square Feet 1380 Linear Feet 460

No. Lines 3 Trench Width 36" Trench Depth 18-30" Gravel Depth 12"

☑ New System ☐ Repair System Type: I. II. III. IV. V. VI

System Description: CONV. GRAVITY

Repair System Description: CONV. GRAVITY

Maintenance Agreement Required: ☐ Yes ☑ No

☑ House/Mod. Home No. Bedrooms 4

☐ Mobile Home No. Bathrooms 2½

☐ Business No. Employees

☐ Other

☐ Slab ☐ Crawl Space ☑ Basement w/plumbing ☐ Basement wo/plumbing

Garbage Disposal: ☑ Yes ☐ No


Auto. Dishwasher: ☑ Yes ☐ No

Auto. Washing Machine: ☑ Yes ☐ No

Other

Comments (1) KEEP SYSTEM MINIMUM 15' FROM BASEMENT, 10' FROM PROPERTY LINE, 100' FROM WELL (2) INSTALL LINES ON CONTOUR, NO DEEPER THAN 30", 9' ON CENTER

INITIAL SITE SKETCH

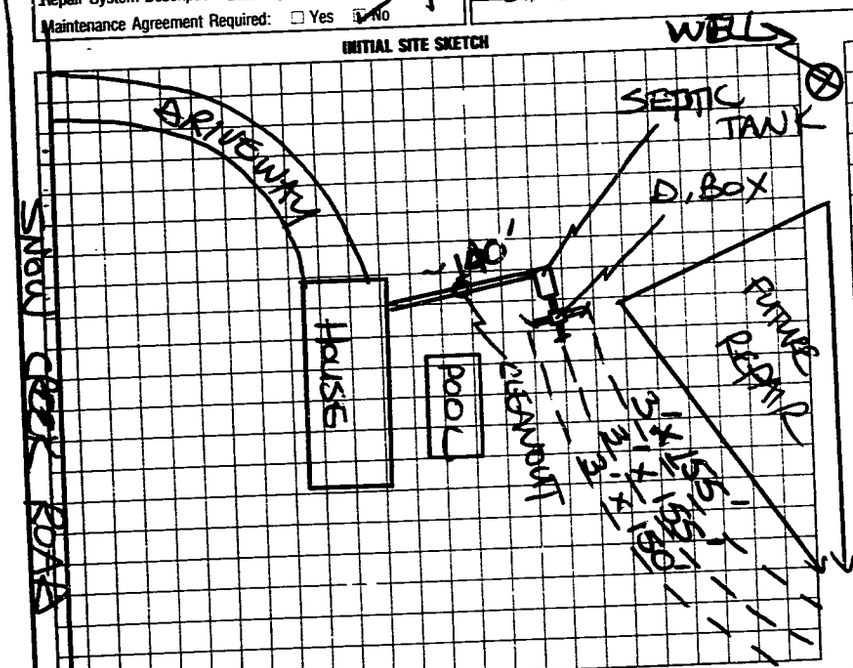

AS BUILT SKETCH

SYSTEM INSTALLED ACCORDING TO INITIAL SITE SKETCH

I understand that this permit can be suspended or revoked if any false information is supplied toward securing the permit/any unauthorized changes are made to the site/any unauthorized changes are made in the installation of the system. Improvement Permit is valid for 60 months from date of issuance.

Signed: X Dennis Leak

Improvement Permit by: STEVE HERRICK date 7/28/93

Existing System Inspection by: date

Installed by: KENNY PEARSON

Certificate of Completion by: STEVE HERRICK date 11/30/93

Operation Permit by: date

HEALTH DEPT. COPY: WHITE INSPECTION COPY (FINAL): GREEN OWNER COPY (FINAL): YELLOW INSPECTION COPY (INITIAL): PINK OWNER COPY (INITIAL): GOLD