IREDELL COUNTY HEALTH DEPARTMENT

STATESVILLE 704-878-5305 MOORESVILLE 704-664-5281 (C1)

IMPROVEMENT PERMIT / AUTHORIZATION TO CONSTRUCT / OPERATION PERMIT / EXISTING SYSTEM INSPECTION

PERMIT# 113604 PIN# 4739-60-1695 DATE 6-18-03

OWNER OR CONTRACTOR BILLYE CRAFT PHONE: Business 704-878-5300 Home

ADDRESS 3764 S. CHIPLEY FORD RD, STATESVILLE NC 28625

LOCATION NC 115 NORTH, TR S. CHIPLEY FORD ROAD, 1ST MH ON RIGHT AT BOX #3764

SUBDIVISION BLOCK / SECTION LOT 2 LOT AREA SITE CLASS. PS DESIGN FLOW 360 L.T.A.R. EXISTING

Septic Tank: 1000 Gallons; STB Date

Pump Tank: Gallons; PT Date

Pump Make: Model Serial No.

Nitrification Field: No Fields 1 Square Feet 750 Linear Feet 250

No Lines TWO Trench Width 36" Max Trench Bottom Depth 36" Gravel Depth 10"

☐ New System ☐ Repair System Type: I, (II), III, IV, V, VI

System Description: CONVENTIONAL, GRAVITY

Repair System Description:

Maintenance Agreement Required: ☐ Yes ☒ No

☐ House/Mod. Home ☒ Mobile Home ☐ Business ☐ Other

No. Bedrooms 3 No. Bathrooms 2 No. Employees

☐ Slab ☒ Crawl Space ☐ Basement w/plumbing ☐ Basement wo/plumbing

Water Supply: ☒ Individual ☐ Public ☐ Community WELL


Comments:/Conditions:

Comments:/Conditions: (1) EXISTING SYSTEM NOT SIZED ACCORDING TO TODAY'S STANDARDS (2) EXISTING S/W MH TO BE REMOVED UPON OCCUPANCY OF D/W MH.

INITIAL SITE SKETCH

AS BUILT SKETCH

SCALE: 1" = 40'

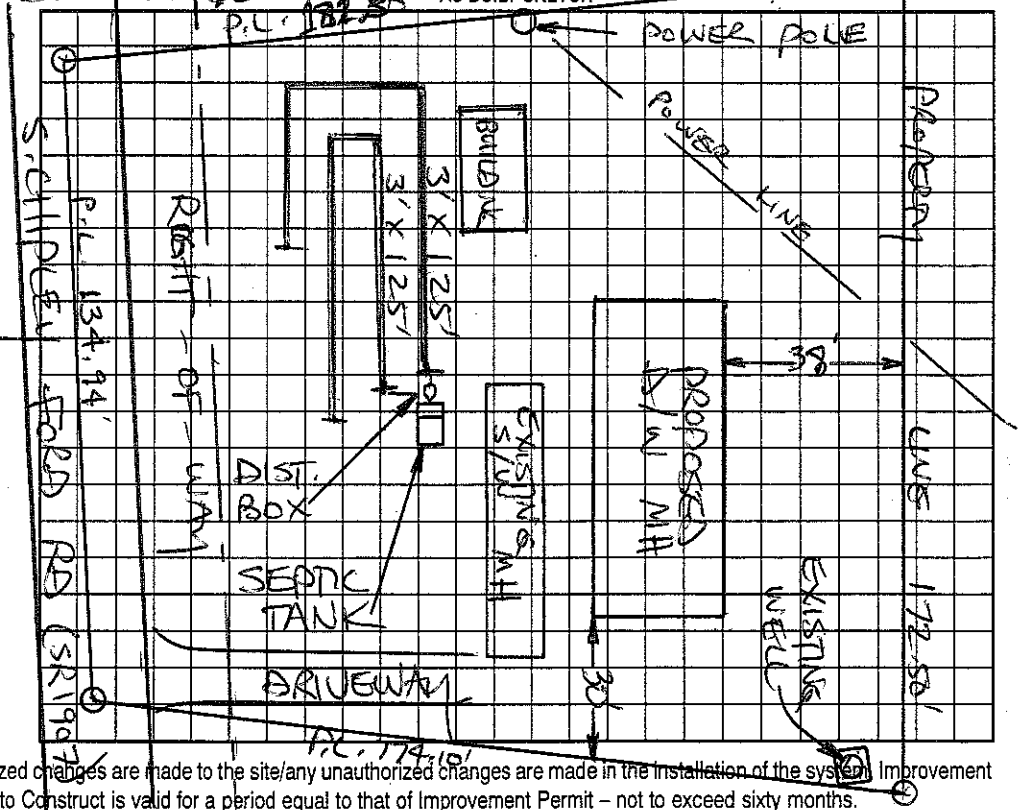

Permit can be suspended or revoked if any false information is supplied toward securing the permit/any unauthorized changes are made to the site/any unauthorized changes are made in the installation of the system. Improvement Permit with plat valid without expiration. Improvement Permit with site plan valid for sixty months. Authorization to Construct is valid for a period equal to that of Improvement Permit – not to exceed sixty months.

Signed: date Installed by:

Improvement Permit by: date Operation Permit by: date

Authorization to Construct by: date Existing System Inspection by: STEVE HEDRICK date 6-18-03

HEALTH DEPT. COPY: WHITE OWNER COPY (FINAL): YELLOW OWNER COPY (INITIAL): PINK