IREDELL COUNTY HEALTH DEPARTMENT

Statesville Office (704) 878-5305 Mooresville Office (704) 660-3625 PERMIT # 214668

IMPROVEMENT PERMIT / AUTHORIZATION TO CONSTRUCT / OPERATION PERMIT / EXISTING SYSTEM

PIN # 4739609185

APPLICANT: Mark Ellis APPLICANT ADDRESS: 200 Hugo Ln Statesville NC 28677

SITE ADDRESS: 138 Dodge Dr Statesville NC 28625 PHONE: 704-902-7576 ALT. PHONE: 902-4829


SITE DIRECTIONS: Take Snow Creek West T/L Chipley Ford Rd T/L Dodge Dr Lot on left

SUBDIVISION: N/A SECTION: N/A LOT # N/A LOT AREA: 15.257ac DESIGN FLOW: Ex L.T.A.R.: Ex

Septic Tank	Ex	(gal)	STB		Date		☐ New System	☐ Repair	☐ Expansion	System Type: I	II	III IV V VI	☒ Residence	No. Bedrooms	Ex	Water Supply
Pump Tank		(gal)	PT		Date		System Description:	Existing					☐ Business	No. Persons	Ex	☑ Private
Pump Make			Model		Serial #		Repair System Description:						☐ Other	No. Employees		☐ Public
# Nitrification Fields	Ex		# Lines	Ex	Linear Ft:	Ex	Maintenance Agreement Required:	☐ YES	☒ NO				☐ Slab	☑ Crawl Space		☐ Community
Trench Width	Ex		Max. Trench Bottom Depth	Ex	Gravel Depth	Ex		☒ GRAVITY	☐ PRESSURE				☐ Basement w/plumbing	☐ Basement w/o plumbing		


Comments / Conditions: All building foundations must be 55' from any part of STS and 325' from any well.

INITIAL SITE SKETCH

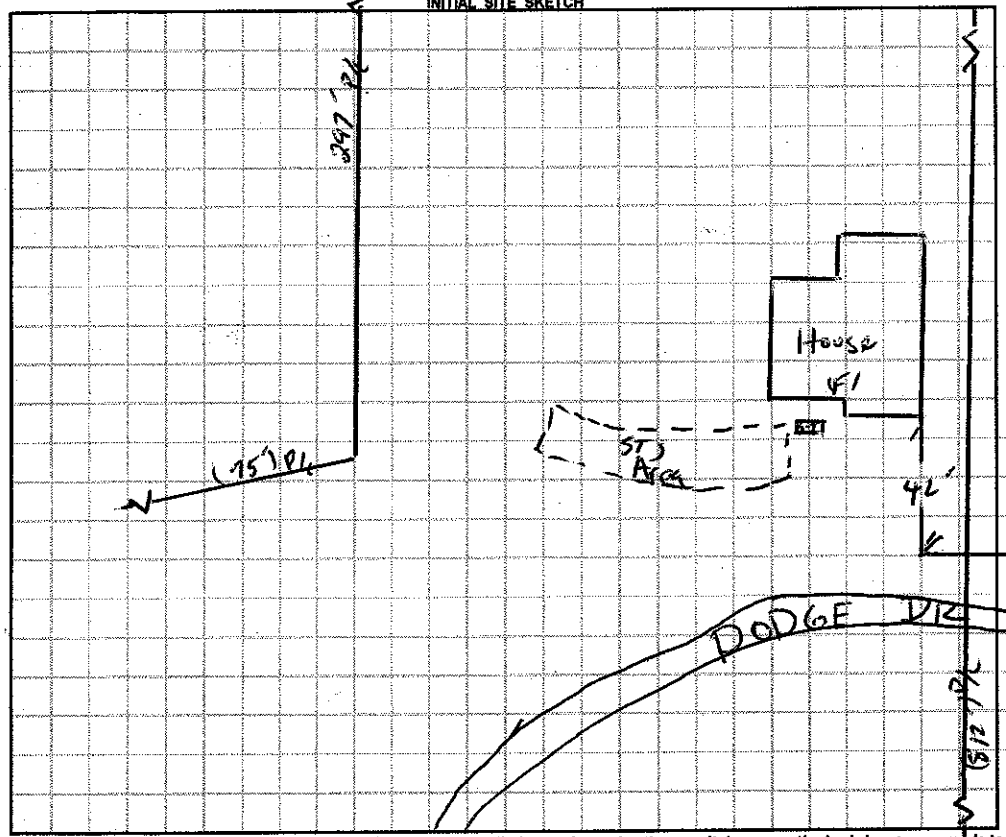

AS BUILT SKETCH

1"=60

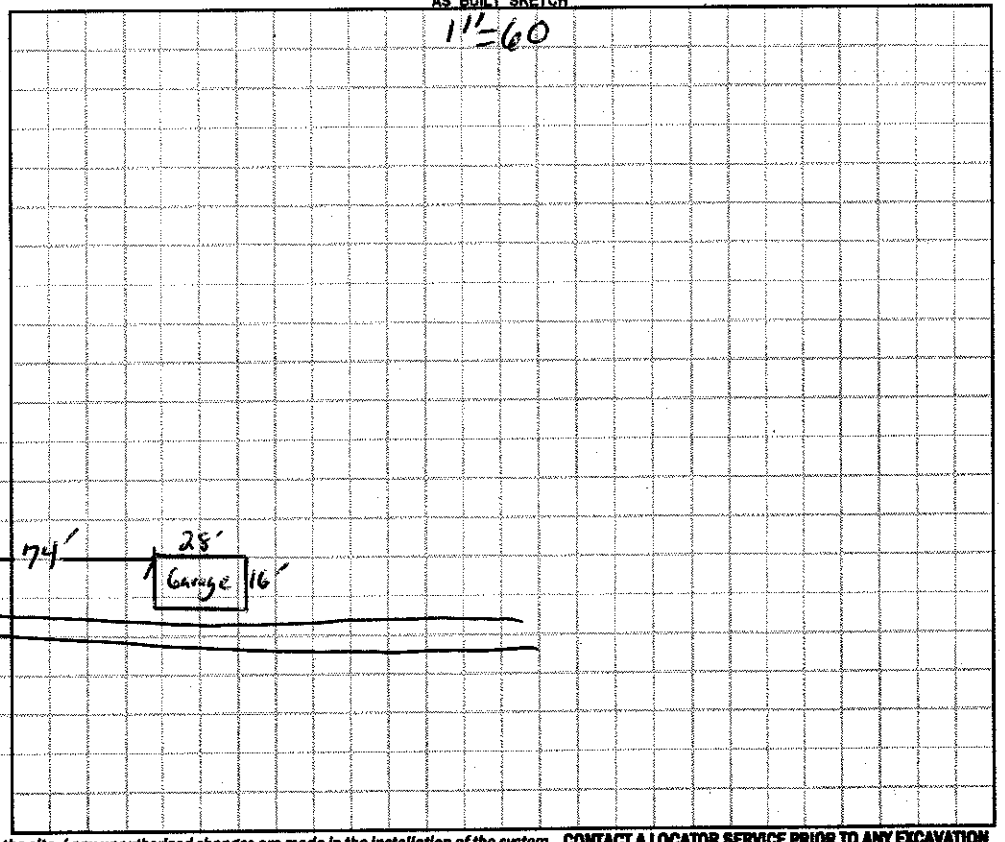

Permit can be suspended or revoked if any false information is supplied toward securing the permit / any unauthorized changes are made to the site / any unauthorized changes are made in the installation of the system. **CONTACT A LOCATOR SERVICE PRIOR TO ANY EXCAVATION**

☐ **IMPROVEMENT PERMIT** *with plat valid without expiration.* ☐ **IMPROVEMENT PERMIT** *with site plan valid for 60 mos.* ☐ **AUTHORIZATION TO CONSTRUCT** *valid for period equal to IMPROVEMENT PERMIT--not to exceed 60 mo.*

Owner / Applicant Signature: Mark Ellis Date: Installed by:

IMPROVEMENT PERMIT by: Date: OPERATION PERMIT by: Date:

AUTHORIZATION TO CONSTRUCT by: Date: Existing System Inspected by: Robert A Lee Date: 12/3/15

Health Dept. Copy - WHITE Applicant (Final Approval) - YELLOW Applicant (Conditional Approval) - PINK