# IREDELL COUNTY HEALTH DEPARTMENT

STATESVILLE 704-878-5305 MOORESVILLE 704-664-5281

## IMPROVEMENT PERMIT / AUTHORIZATION TO CONSTRUCT / OPERATION PERMIT / EXISTING SYSTEM INSPECTION

PERMIT# 077146 PIN# 4739 60 8651 (PART) DATE 10-21-98

OWNER OR CONTRACTOR WADE DANIELS PHONE: Business Home 876-4500

ADDRESS 3780 S. CHIPLEY FORD ROAD STATESVILLE, NC 28625

LOCATION NC 115 N, TR S. CHIPLEY FORD ROAD; TR DODGE DRIVE, ~300' ON RIGHT

SUBDIVISION BLOCK / SECTION LOT LOT AREA SITE CLASS PS DESIGN FLOW 360 L.T.A.R. EXISTING 0.4

Septic Tank: 1000 Gallons; STB Date

Pump Tank: Gallons; PT Date

Pump Make: Model Serial No.

Nitrification Field: No Fields 1 Square Feet 900 Linear Feet 300

No Lines THREE Trench Width Max Trench Bottom Depth Gravel Depth

~~New System~~ ~~Repair~~ System Type: I II III IV V VI

System Description: CONVENTIONAL, GRAVITY

Repair System Description: CONV. GRAVITY

Maintenance Agreement Required: Yes No

House/Mod. Home No. Bedrooms 3

Mobile Home No. Bathrooms 2

Business No. Employees

Other

Slab Crawl Space Basement w/plumbing Basement wo/plumbing


Water Supply: Individual Public Community

Comments:/Conditions:

Comments:/Conditions:

INITIAL SITE SKETCH

AS BUILT SKETCH

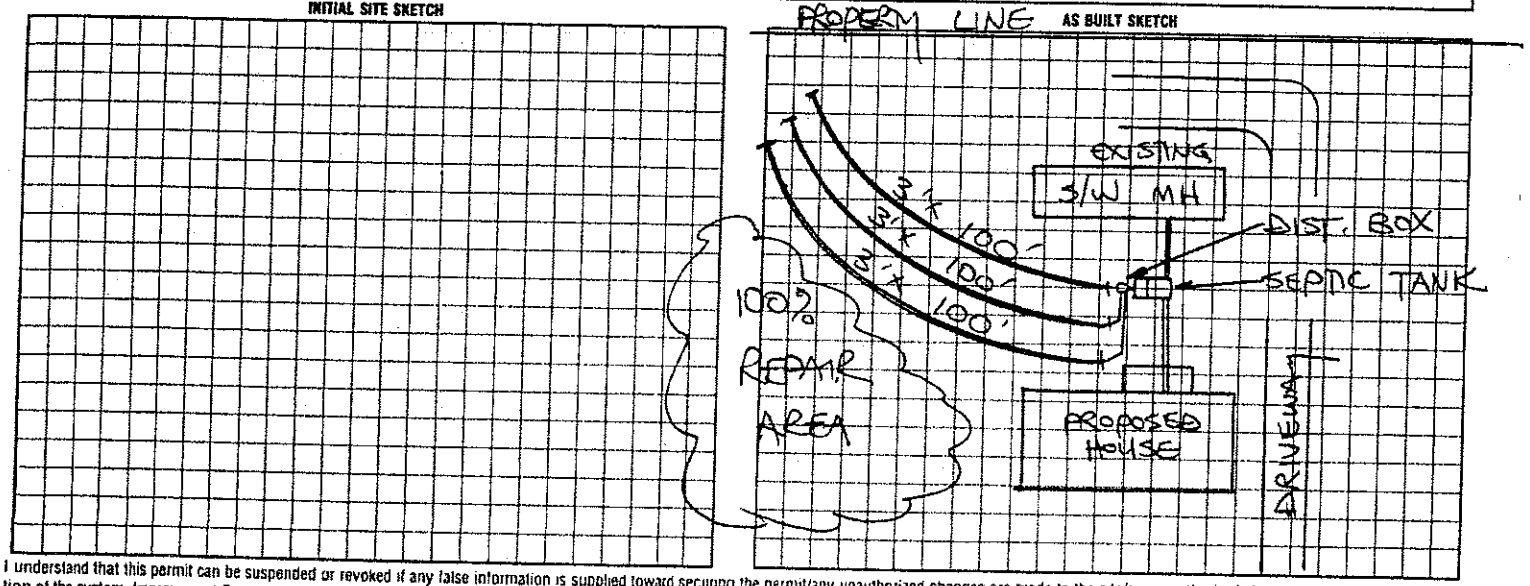


I understand that this permit can be suspended or revoked if any false information is supplied toward securing the permit/any unauthorized changes are made to the site/any unauthorized changes are made in the installation of the system. Improvement Permit with plat valid without expiration. Improvement Permit with site plan valid for sixty months. Authorization to Construct is valid for a period equal to that of Improvement Permit – not to exceed sixty months.

Signed: date Installed by:

Improvement Permit by: date Operation Permit by date

Authorization to Construct by: date Existing System Inspection by: STEVE HARRICK date 10-21-98

HEALTH DEPT. COPY. WHITE INSPECTION COPY (FINAL). GREEN OWNER COPY (FINAL) YELLOW INSPECTION COPY (INITIAL) PINK OWNER COPY (INITIAL) GOLD