IREDELL COUNTY HEALTH DEPARTMENT

STATESVILLE 704-878-5305 MOORESVILLE 704-664-5281

IMPROVEMENT PERMIT / AUTHORIZATION TO CONSTRUCT / OPERATION PERMIT / EXISTING SYSTEM INSPECTION

PERMIT# Repair PIN# 4739-81-2177 DATE 3/28/03

OWNER OR CONTRACTOR Sam G. Hall PHONE: Business — Home (704) 876-6211

ADDRESS Snow Creek Rd Statesville, N.C. 28625

LOCATION Hwy 115 N, @ Snow Creek Rd, House Past Chipley Ford Rd on right

SUBDIVISION — BLOCK / SECTION — LOT — LOT AREA — SITE CLASS. 5B DESIGN FLOW — L.T.A.R. —

Septic Tank: Ex. Gallons; STB — Date —

Pump Tank: — Gallons; PT — Date —

Pump Make: — Model — Serial No. —

Nitrification Field: No Fields 1 Square Feet 900 Linear Feet 300 Ft

No Lines 3 Trench Width 3Ft Max Trench Bottom Depth — Gravel Depth 12"

☐ New System ☒ Repair System Type: I, II, III, IV, V, VI

System Description: —

Repair System Description: Gravity, Conv.

Maintenance Agreement Required: ☐ Yes ☒ No

☒ House/Mod. Home ☐ Mobile Home ☐ Business ☐ Other

No. Bedrooms 2 No. Bathrooms 3 No. Employees —


Water Supply: ☒ Individual ☐ Public ☐ Community

☐ Slab ☐ Crawl Space ☒ Basement w/plumbing ☐ Basement wo/plumbing

Comments:/Conditions: Dig Subsurface drain around Septic lines 8 Ft to daylight

Comments:/Conditions:

INITIAL SITE SKETCH (not to Scale)

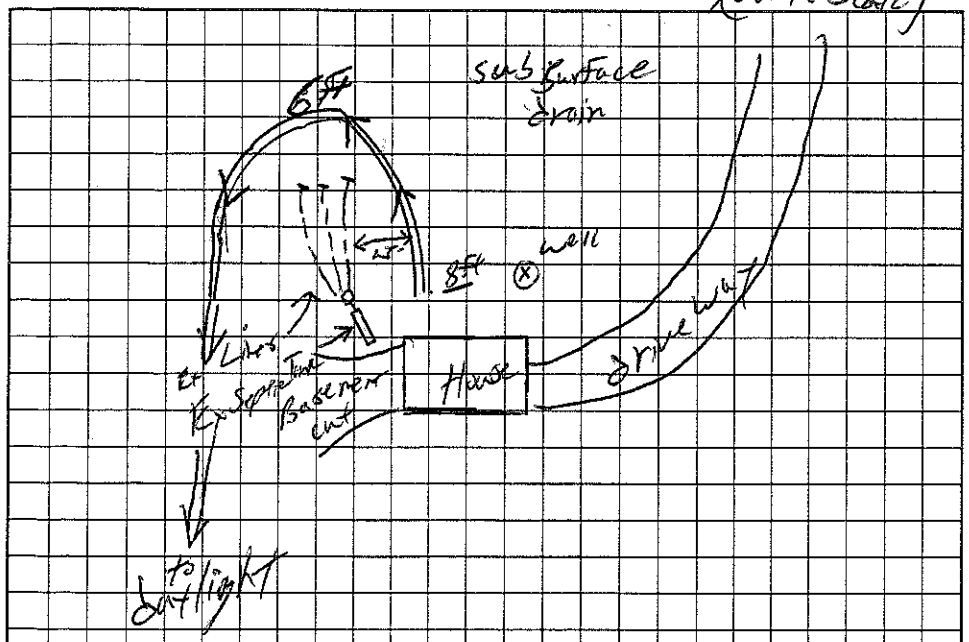

AS BUILT SKETCH

Installed 8 French Drain As Shown

Permit can be suspended or revoked if any false information is supplied toward securing the permit/any unauthorized changes are made to the site/any unauthorized changes are made in the installation of the system. Improvement Permit with plat valid without expiration. Improvement Permit with site plan valid for sixty months. Authorization to Construct is valid for a period equal to that of Improvement Permit – not to exceed sixty months.

Signed: Sam Hall date —

Improvement Permit by: William O. Johnson date 3/28/03

Authorization to Construct by: William O. Johnson date 3/28/03

Installed by: Sam Hall

Operation Permit by: William O. Johnson date 4/1/03

Existing System Inspection by: — date —

HEALTH DEPT. COPY: WHITE OWNER COPY (FINAL): YELLOW OWNER COPY (INITIAL): PINK