IREDELL COUNTY HEALTH DEPARTMENT

STATESVILLE 704-878-5305 MOORESVILLE 704-664-5281

IMPROVEMENT PERMIT / AUTHORIZATION TO CONSTRUCT / OPERATION PERMIT / EXISTING SYSTEM INSPECTI

PERMIT# 083614 PIN# 4740007686 DATE 10-12-9

OWNER OR CONTRACTOR Alt Inc Inc PHONE: Business 855-2300 Home Cell 202-5234

ADDRESS 450 Auction Dr Salisbury, NC 28146

LOCATION Perth Rd TR Clontz Hill TR Ridge Creek TR Brook Creek on right

SUBDIVISION Rocky Creek Cove BLOCK / SECTION LOT 64 LOT AREA 1.59 Acre SITE CLASS. PS DESIGN FLOW 360gpd L.T.A.R. .3

Septic Tank: 1000 Gallons; STB 312 Date 12-12-99

Pump Tank: Gallons; PT Date

Pump Make: Model Serial No.

Nitrification Field: No Fields 1 Square Feet 900' Linear Feet 300'

No Lines 3 at 100' Trench Width 36" Max Trench Bottom Depth 36" Gravel Depth N/A

☒ New System ☐ Repair System Type: I, II, III, IV, V, VI

System Description: Gravity - 25% Reduction

Repair System Description: Pumped - Innovative

Maintenance Agreement Required: ☐ Yes ☒ No

☐ House/Mod. Home No. Bedrooms 3

☒ Mobile Home No. Bathrooms 2

☐ Business No. Employees

☐ Other


☐ Slab ☒ Crawl Space ☐ Basement w/plumbing ☐ Basement wo/plumbing

Water Supply: ☒ Individual ☐ Public ☐ Community


Comments/Conditions: Keep Septic System at least 10' from PL, 5' from House & 50' from Creek & well.

Comments/Conditions: Installed as Drawn

INITIAL SITE SKETCH Scale 1"=50'

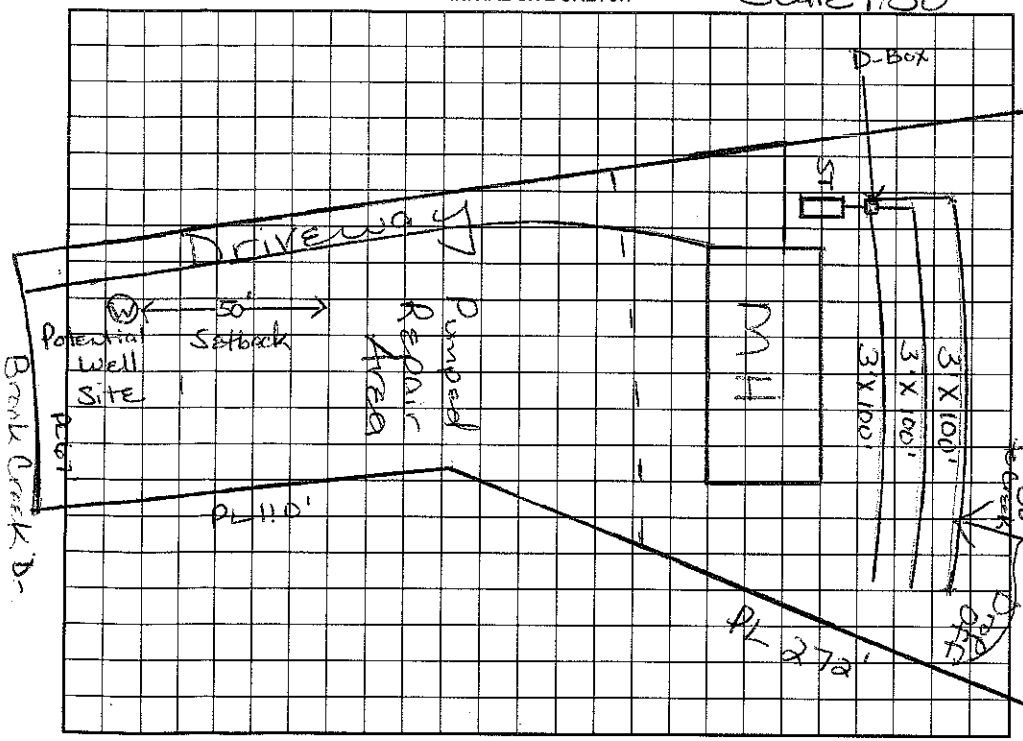

AS BUILT SKETCH

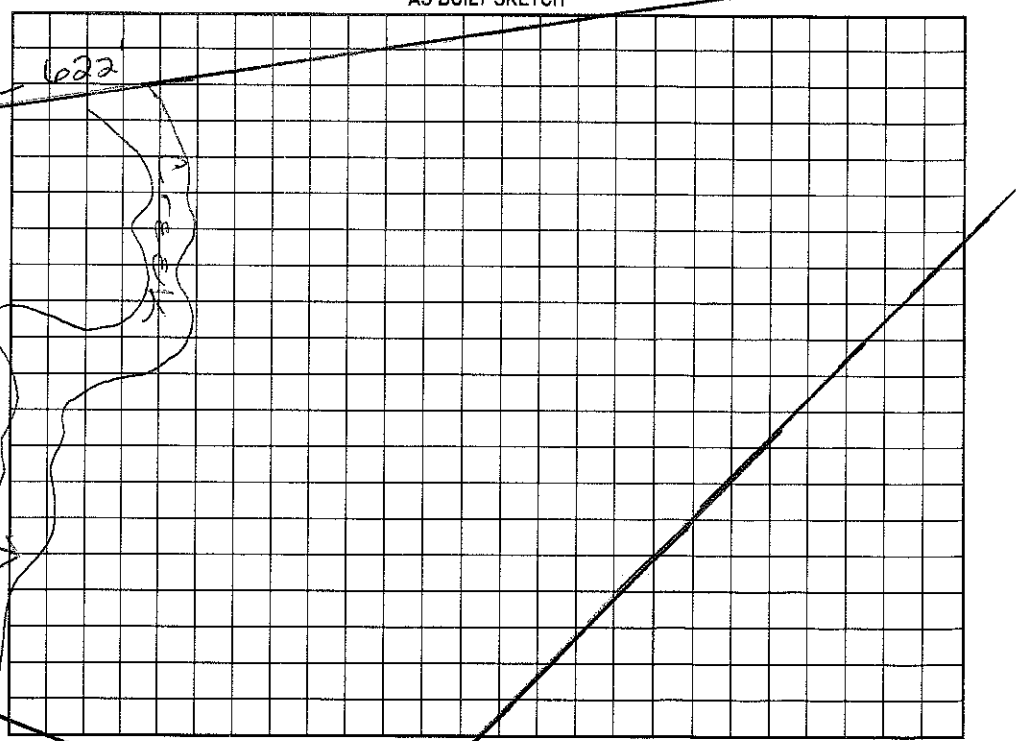

Permit can be suspended or revoked if any false information is supplied toward securing the permit/any unauthorized changes are made to the site/any unauthorized changes are made in the installation of the system. Improvement Permit with plat valid without expiration. Improvement Permit with site plan valid for sixty months. Authorization to Construct is valid for a period equal to that of Improvement Permit – not to exceed sixty months.

Signed: date 10-19-99 Installed by: Madison Bros

Improvement Permit by: Maina H. Holt RS date 10/13/99 Operation Permit by: Maina H. Holt RS date 11/08/2000

Authorization to Construct by: Maina H. Holt RS date 10/13/99 Existing System Inspection by: date

HEALTH DEPT. COPY: WHITE OWNER COPY (FINAL): YELLOW OWNER COPY (INITIAL): PINK