(400)

IREDELL COUNTY HEALTH DEPARTMENT

STATESVILLE 704-878-5305 MOORESVILLE 704-664-5281

IMPROVEMENT PERMIT / AUTHORIZATION TO CONSTRUCT / OPERATION PERMIT / EXISTING SYSTEM INSPECTION

PERMIT# 080105 PIN# 4740009513 DATE 5/12/99

OWNER OR CONTRACTOR A-1 Inc PHONE: Business 704-855-1999 Home

ADDRESS 420 Auction Dr, Salisbury NC 28144

LOCATION Perth, TL Cloantz Hill, TR Ridge Clr, TR Brook Clr, ON RT

SUBDIVISION Rocky River Cove BLOCK / SECTION LOT 65 LOT AREA 2.21 SITE CLASS. PS DESIGN FLOW 360 L.T.A.R. 1.3

Septic Tank: 1000 Gallons; STB 375 Date 5/11/99
Pump Tank: 1000 Gallons; PT 47 Date 5/11/99
Pump Make: HYDROMATIC Model SHG1 Serial No.
Nitrification Field: No Fields 1 Square Feet 1200 Linear Feet 400
No Lines ~~40~~ 10 Trench Width 36" Max Trench Bottom Depth 36"

☒ New System ☐ Repair System Type: I (II) III IV, V, VI
System Description: ~~Conv~~ Pump/Pressure Manif
Repair System Description: Chamber/Panel
Maintenance Agreement Required: ☐ Yes ☐ No

☒ House/Mod. Home No. Bedrooms 3
☐ Mobile Home No. Bathrooms 2
☐ Business No. Employees
☐ Other


Water Supply: ☒ Individual ☐ Public ☐ Community

Gravel Depth 12" ☐ Slab ☒ Crawl Space ☐ Basement w/plumbing ☐ Basement wo/plumbing


Comments:/Conditions: 3 @ 100'
25% Reduction

Comments:/Conditions:

INITIAL SITE SKETCH

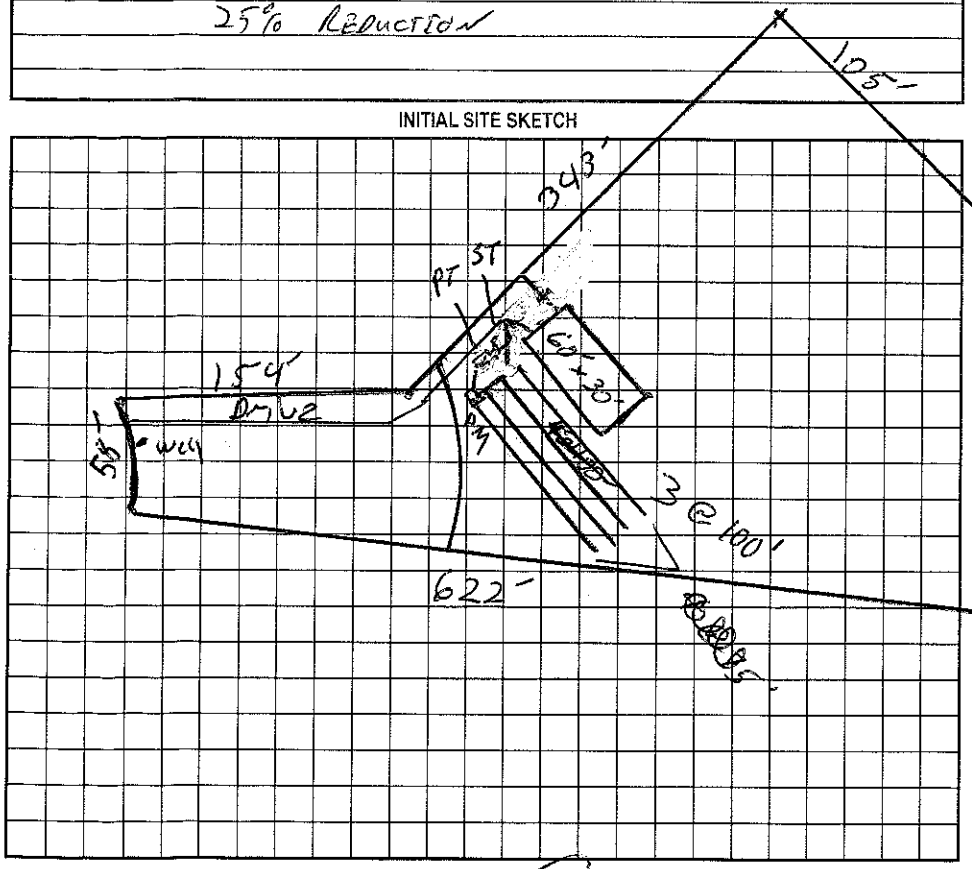

1=100 AS BUILT SKETCH

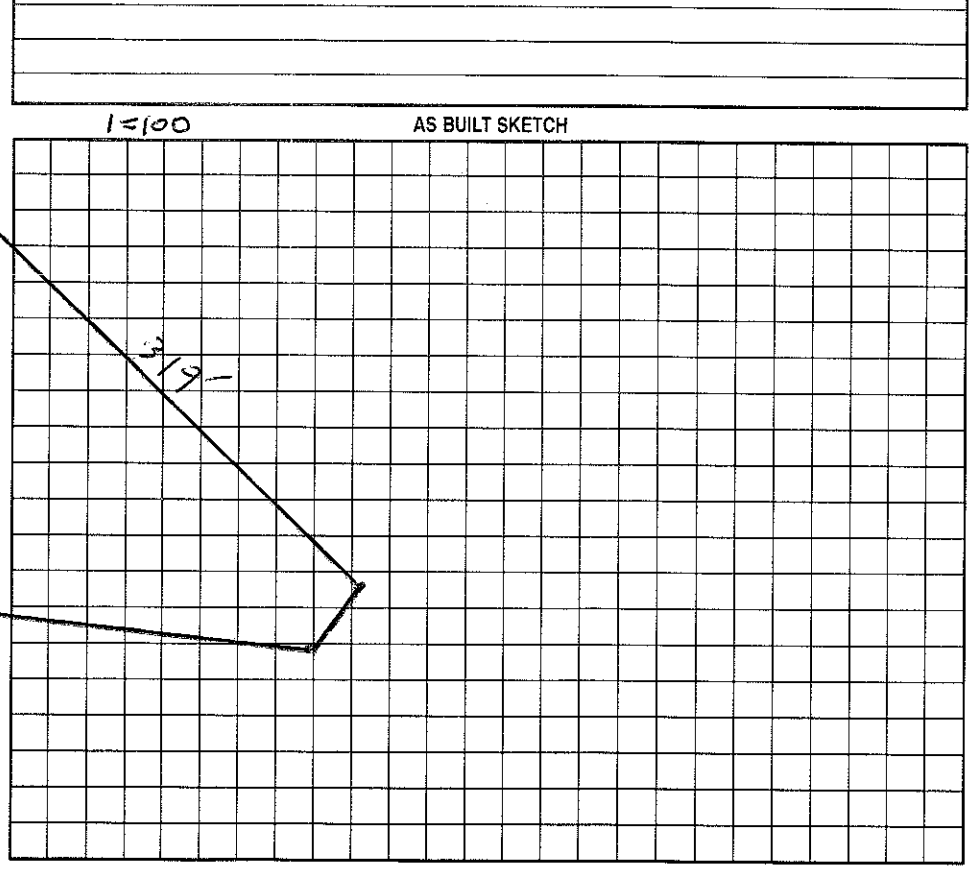

Permit can be suspended or revoked if any false information is supplied toward securing the permit/any unauthorized changes are made to the site/any unauthorized changes are made in the installation of the system. Improvement Permit with plat valid without expiration. Improvement Permit with site plan valid for sixty months. Authorization to Construct is valid for a period equal to that of Improvement Permit – not to exceed sixty months.

Signed: _____ date 5-13-99 Installed by: Rowan SRP

Improvement Permit by: Jeff Morgan date 5/13/99 Operation Permit by: Jeff Morgan date 6-22-99

Authorization to Construct by: Jeff Morgan date 5/13/99 Existing System Inspection by: _____ date _____

HEALTH DEPT. COPY: WHITE OWNER COPY (FINAL): YELLOW OWNER COPY (INITIAL): PINK