IREDELL COUNTY HEALTH DEPARTMENT

STATESVILLE 704-878-5305 50.00 Paid MOORESVILLE 704-664-528

IMPROVEMENT PERMIT / AUTHORIZATION TO CONSTRUCT / OPERATION PERMIT / EXISTING SYSTEM INSPECTION

PERMIT# 105666 PIN# 4740 01 3354 DATE 9/12/02

OWNER OR CONTRACTOR AH Invs. / Rocky River LLC PHONE: Business 704-202-5234 Home

ADDRESS 450 Auction Dr. Salisbury, NC. 28147

LOCATION Perth N TR. County Hill Rd TR Ridge Creek Dr. top of hill on (R)

SUBDIVISION Rocky Creek Cove BLOCK / SECTION LOT 55 LOT AREA 1.2 SITE CLASS. PS DESIGN FLOW 360 L.T.A.R. .3

Septic Tank: 1000 Gallons; STB Date

Pump Tank: Gallons; PT Date

Pump Make: Model Serial No.

Nitrification Field: No Fields 1 Square Feet 900 ± Linear Feet 300 ±

No Lines 3 @ 100' Trench Width 3' Max Trench Bottom Depth 3' Gravel Depth No

[X] New System ☐ Repair System Type: I, II, III, IV, V, VI

System Description: GRAV - 25% Reduced

Repair System Description: Same

Maintenance Agreement Required: ☐ Yes [X] No

[X] House/Mod. Home No. Bedrooms 3

☐ Mobile Home No. Bathrooms 3

☐ Business No. Employees

☐ Other


☐ Slab ☐ Crawl Space ☐ Basement w/plumbing ☐ Basement wo/plumbing

Water Supply: [X] Individual ☐ Public ☐ Community


Comments:/Conditions:

Comments:/Conditions: 9/16/02 - No driveway at inspection. Infiltrator installed.

INITIAL SITE SKETCH (1" = 50')

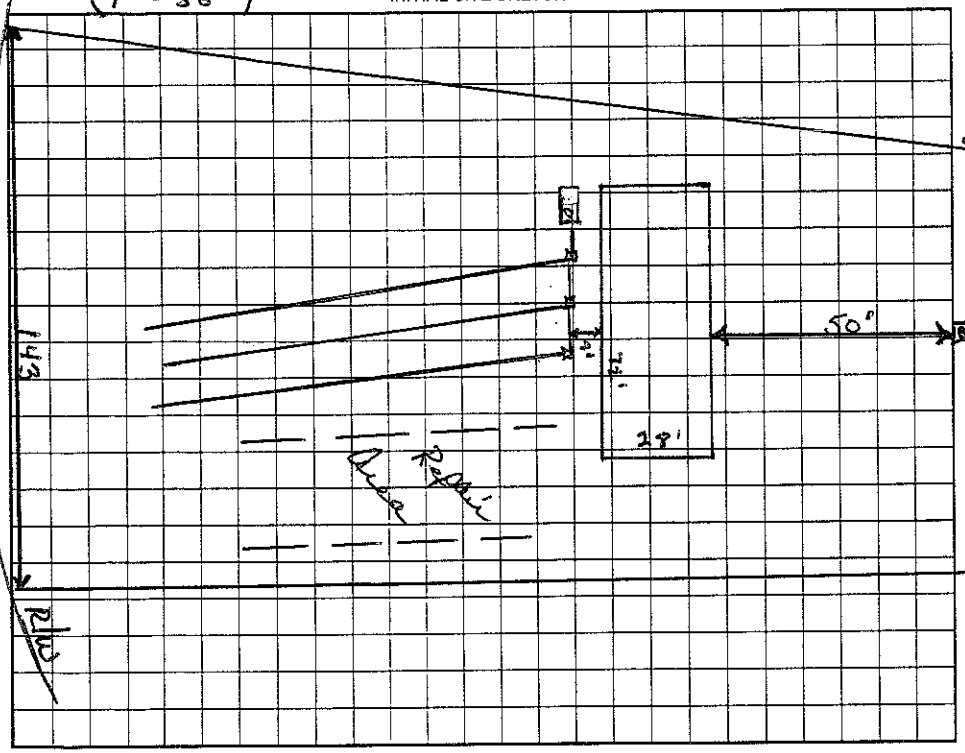

AS BUILT SKETCH

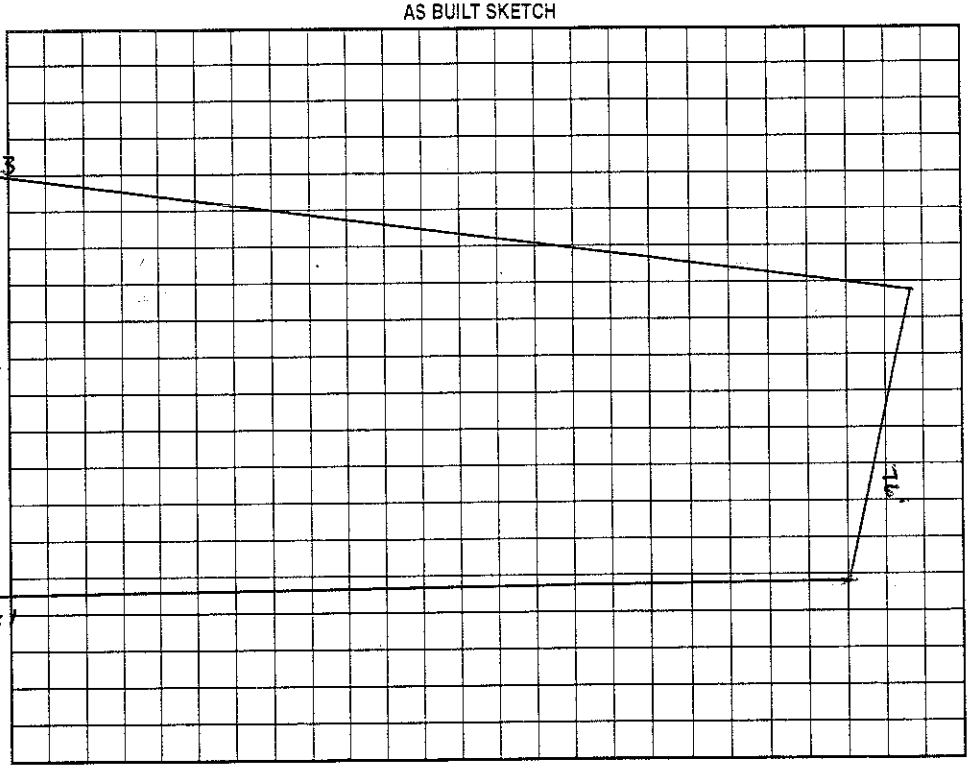

Permit can be suspended or revoked if any false information is supplied toward securing the permit/any unauthorized changes are made to the site/any unauthorized changes are made in the installation of the system. Improvement Permit with plat valid without expiration. Improvement Permit with site plan valid for sixty months. Authorization to Construct is valid for a period equal to that of Improvement Permit – not to exceed sixty months.

Signed: date 10-9-03

Improvement Permit by: date

Authorization to Construct by: date

Installed by: Kenny Madison

Operation Permit by: Wesley Sparks R.S. date 9/16/02

Existing System Inspection by: date

HEALTH DEPT. COPY: WHITE OWNER COPY (FINAL): YELLOW OWNER COPY (INITIAL): PINK