IREDELL COUNTY HEALTH DEPARTMENT

STATESVILLE 704-878-5305 $139 MOORESVILLE 704-664-5281 4:00

IMPROVEMENT PERMIT / AUTHORIZATION TO CONSTRUCT / OPERATION PERMIT / EXISTING SYSTEM INSPECTION

PERMIT# 11470 PIN# 4740 01 7033 Jerry Smith DATE 8-18-03

OWNER OR CONTRACTOR James Singleton (Jerry Smith) PHONE: Business 902-1836 Home (704) 528-9206

ADDRESS 210 Old Murdock Rd. Troutman NC 28166

LOCATION Hwy 115 N TL Flowerhouse TL Clontz Hill Rd TL Rocky Creek TR Brook Creek on right

SUBDIVISION Rocky Creek Cove BLOCK / SECTION ____ LOT 61 LOT AREA 1.01 Acre SITE CLASS. PS DESIGN FLOW 480 gpd L.T.A.R. .325

Septic Tank: 1000 Gallons; STB 1012 Date 2-20-03
Pump Tank: ____ Gallons; PT ____ Date ____
Pump Make: ____ Model ____ Serial No. ____
Nitrification Field: No Fields 1 Square Feet 500'± Linear Feet 250'+
No Lines 5 @ 50' Trench Width 24"-36" Max Trench Bottom Depth 36" Gravel Depth N/A

☒ New System ☐ Repair System Type: I II III IV V VI
System Description: Gravity-Panel Blk
Repair System Description: LPP Panel Blk
Maintenance Agreement Required: ☐ Yes ☐ No

☐ House/Mod. Home ☒ Mobile Home ☐ Business ☐ Other
No. Bedrooms 4 No. Bathrooms 2 No. Employees ____


Water Supply: ☒ Individual ☐ Public ☐ Community

☐ Slab ☒ Crawl Space ☐ Basement w/plumbing ☐ Basement wo/plumbing


Comments:/Conditions: Keep at least 10' from PL with Septic System

Comments:/Conditions: ☒ Must keep 100' between well & Septic System.
Filter Installed.

INITIAL SITE SKETCH Scale 1:50

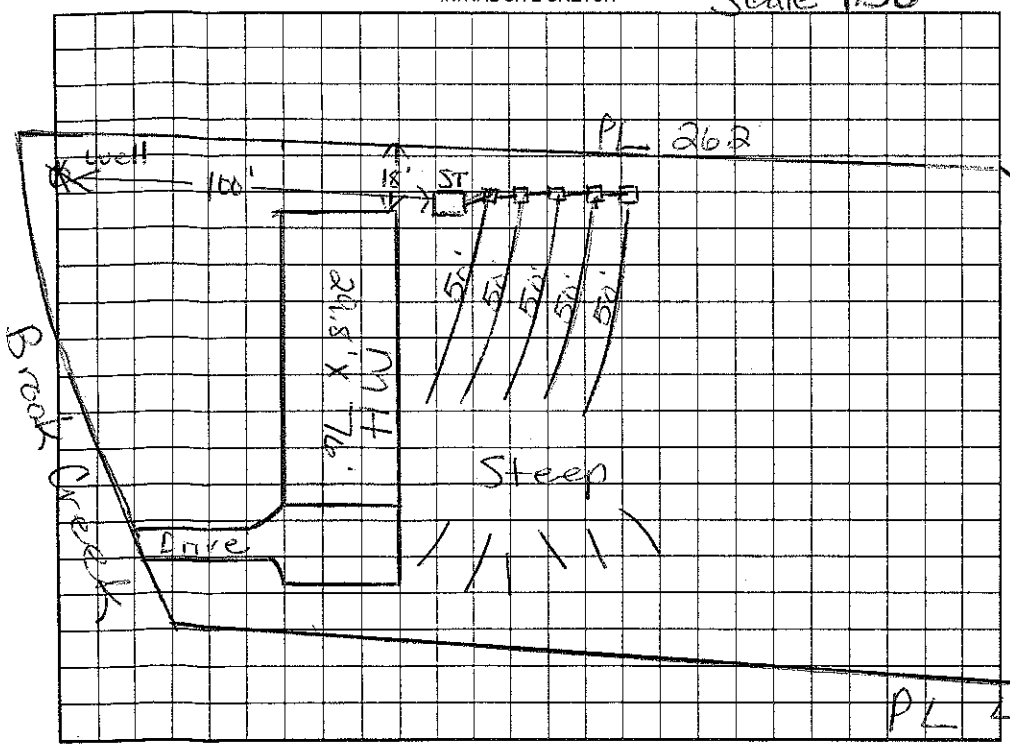

AS BUILT SKETCH

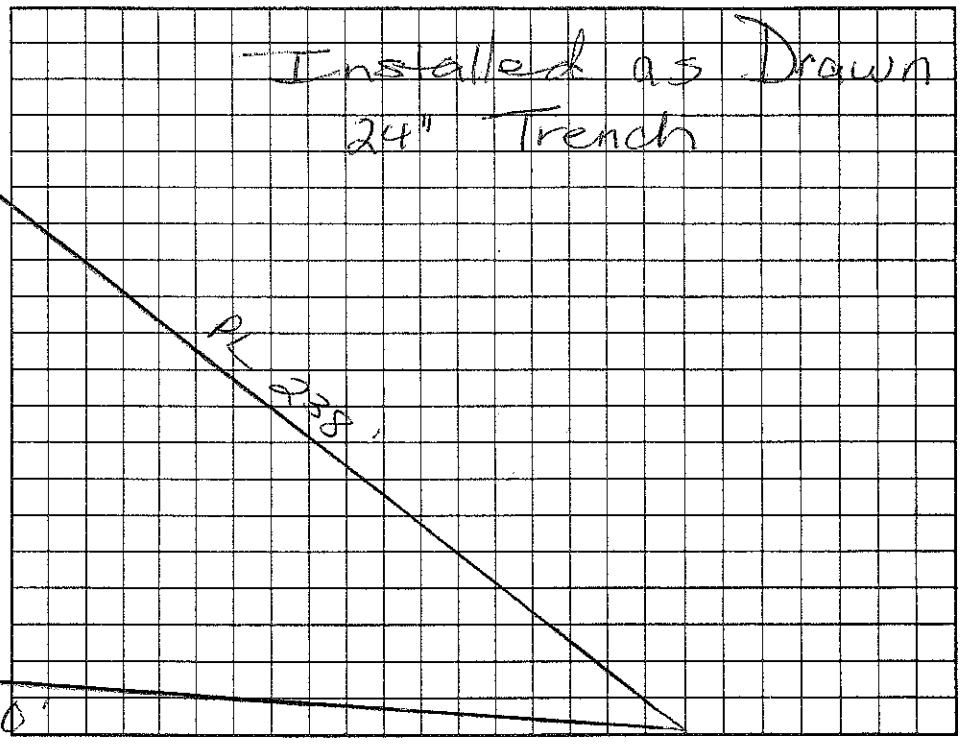

Permit can be suspended or revoked if any false information is supplied toward securing the permit/any unauthorized changes are made to the site/any unauthorized changes are made in the installation of the system. Improvement Permit with plat valid without expiration. Improvement Permit with site plan valid for sixty months. Authorization to Construct is valid for a period equal to that of Improvement Permit – not to exceed sixty months.

Signed: Jerry Smith date 21 Aug 03

Improvement Permit by: Maria H.H. Dotson RS date 8/18/03

Authorization to Construct by: Maria H.H. Dotson RS date 8/18/03

Installed by: A-1 Backhoe RS.

Operation Permit by: Maria H.H. Dotson date 9/8/03

Existing System Inspection by: ____ date ____

HEALTH DEPT. COPY: WHITE OWNER COPY (FINAL): YELLOW OWNER COPY (INITIAL): PINK