4740-01-7005 ~ 3:00

IREDELL COUNTY HEALTH DEPARTMENT Const. Auth. STATESVILLE 704-878-5305 MOORESVILLE 704-664-5281

IMPROVEMENT PERMIT / ~~CERTIFICATE OF COMPLETION~~ / OPERATION PERMIT / EXISTING SYSTEM INSPECTI

PROPERTY DESCRIPTION NO. 21509 DATE Oct. 6, '97 TAX MAP NO. part of 3FA24 Watershed: ☑ Yes ☐ No

OWNER OR CONTRACTOR A H Inc. PHONE: Business 636-7765 Home

ADDRESS 2310 S. Main St. Salisbury 28147

LOCATION County Hill Rd. turn on Ridgecreek on left

SUBDIVISION Rocky Creek BLOCK / SECTION LOT 8 LOT AREA 115'x200' SITE CLASS. RS DESIGN FLOW 360 gpd L.T.A.R. ~.3

Septic Tank: 1,000 Gallons; STB 825 Date 9/11/97

Pump Tank: Gallons; PT Date

Pump Make: Model Serial No.

Nitrification Field: No Fields 1 Square Feet 400 Linear Feet 200

No Lines 4 @ 67' Trench Width 24" Max Trench Bottom Depth 30" Gravel Depth NA

☑ New System ☐ Repair System Type: I, II, III, IV, V, VI

System Description: gravity ~~panel block~~

Repair System Description: Same

Maintenance Agreement Required: ☐ Yes ☑ No

☐ House/Mod. Home No. Bedrooms 3

☑ Mobile Home No. Bathrooms 2

☐ Business No. Employees

☐ Other


☐ Slab ☑ Crawl Space ☐ Basement w/plumbing ☐ Basement wo/plumbing

Water Supply:
☑ Individual
☐ Community
☐ Public

Comments:

Comments: Chamberlend Plastic

INITIAL SITE SKETCH

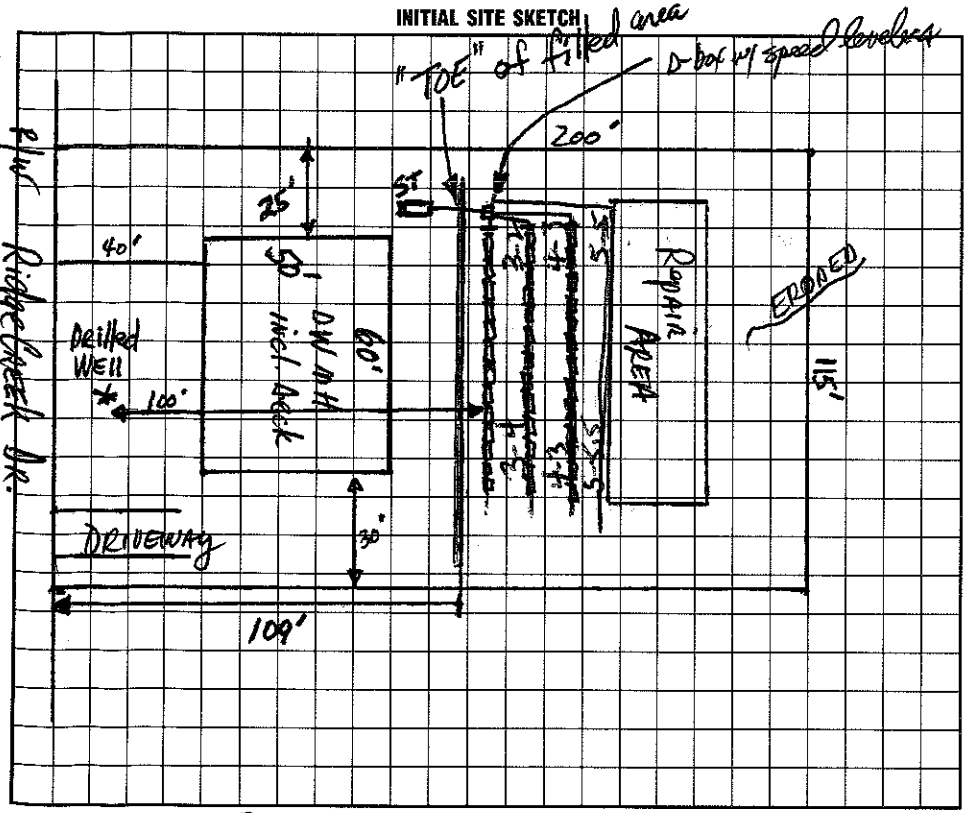

AS BUILT SKETCH

I understand that this permit can be suspended or revoked if any false information is supplied toward securing the permit/any unauthorized changes are made to the site/any unauthorized changes are made in the installation of the system. Improvement Permit is valid for 60 months from date of issuance.

Signed:

Improvement Permit by: D Harmon, RS date 10-6-97

~~Construction/Existing System Inspection by:~~ D Harmon, RS date 10-6-97

Authorization

Installed by: Rowan Septic Tank

Certificate of Completion by: Wesley Sparks RS date 11/19/97

Operation Permit by: Wesley Sparks RS date 11/19/97

HEALTH DEPT. COPY: WHITE INSPECTION COPY (FINAL): GREEN OWNER COPY (FINAL): YELLOW INSPECTION COPY (INITIAL): PINK OWNER COPY (INITIAL): GOLD