IREDELL COUNTY HEALTH DEPARTMENT

Const. Auth 4740-01-8490

STATESVILLE 704-878-5305 MOORESVILLE 704-664-5281

IMPROVEMENT PERMIT / ~~CERTIFICATE OF COMPLETION~~ / OPERATION PERMIT / EXISTING SYSTEM INSPECTION

PROPERTY DESCRIPTION NO. 21557 DATE Oct-6, '97 TAX MAP NO. part of 3FA24 Watershed: ☑ Yes ☐ No

OWNER OR CONTRACTOR AH INC PHONE: Business 636-7765 Home

ADDRESS 2310 S. Main St Salisbury 28147

LOCATION Old Beatty Ford Rd. turn Ridge Creek Dr. on Right, at jct w/ Brookcreek Dr.

SUBDIVISION Rocky Creek BLOCK / SECTION LOT 51 LOT AREA ~120 x 210' SITE CLASS. PS DESIGN FLOW 360gpd L.T.A.R. .3

Septic Tank: 1000 Gallons; STB 825 Date 9/16/97

Pump Tank: Gallons; PT Date

Pump Make: Model Serial No.

Nitrification Field: No Fields 1 Square Feet 900 Linear Feet 300

No Lines 3@150' Trench Width 36" Max Trench Bottom Depth 24" Gravel Depth NA

☑ New System ☐ Repair System Type: I, II, III, IV, V, VI

System Description: quarry chambered

Repair System Description: same

Maintenance Agreement Required: ☐ Yes ☑ No

☐ House/Mod. Home No. Bedrooms 3

☑ Mobile Home No. Bathrooms 2

☐ Business No. Employees

☐ Other

☐ Slab ☑ Crawl Space ☐ Basement w/plumbing ☐ Basement wo/plumbing


Water Supply: ☑ Individual ☐ Community ☐ Public

Comments:

Comments:

INITIAL SITE SKETCH

1"=50'

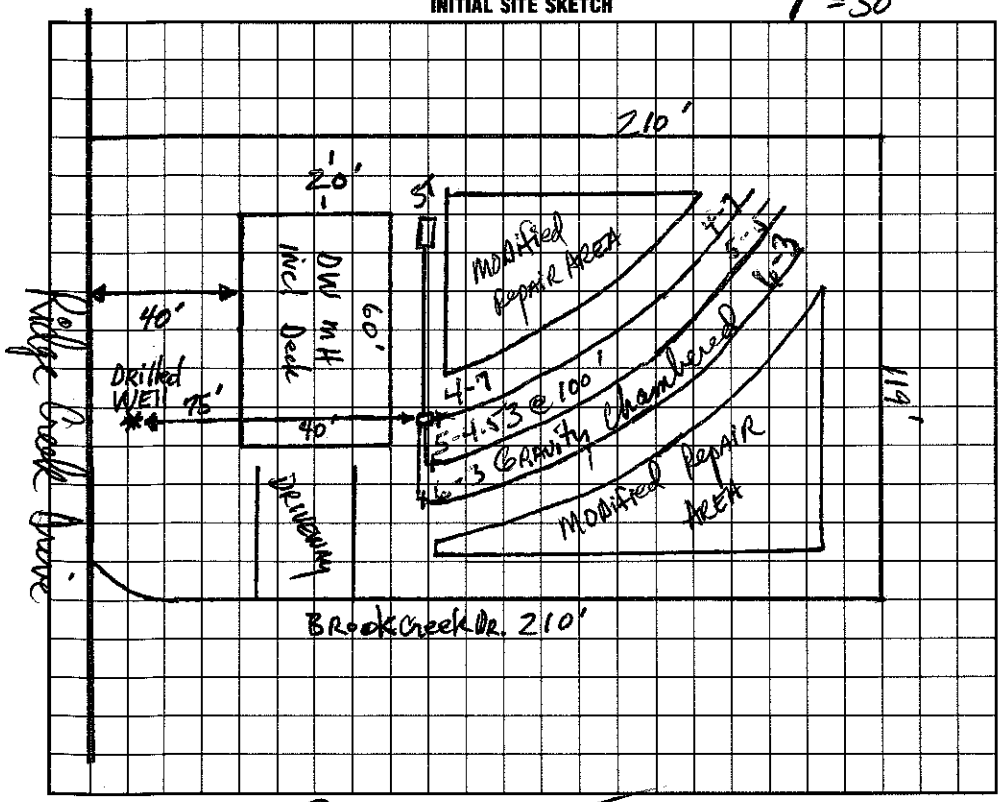

AS BUILT SKETCH

I understand that this permit can be suspended or revoked if any false information is supplied toward securing the permit/any unauthorized changes are made to the site/any unauthorized changes are made in the installation of the system. Improvement Permit is valid for 60 months from date of issuance.

Signed:

Improvement Permit by: OR Hanson RS date 10-6-97

~~Existing System Inspection by:~~ Construction Authorization OR Hanson RS date 10-6-97

Installed by: Rowan Septic Tank

Certificate of Completion by: Wesley Sparks RS. date 11/17/97

Operation Permit by: date 11/17/97

HEALTH DEPT. COPY: WHITE INSPECTION COPY (FINAL): GREEN OWNER COPY (FINAL): YELLOW INSPECTION COPY (INITIAL): PINK OWNER COPY (INITIAL): GOLD