IREDELL COUNTY HEALTH DEPARTMENT

Const. Auth 4740-01-8684

STATESVILLE 704-878-5305 MOORESVILLE 704-664-5281

IMPROVEMENT PERMIT / ~~CERTIFICATE OF COMPLETION~~ / OPERATION PERMIT / EXISTING SYSTEM INSPECTION

PROPERTY DESCRIPTION NO. 21511 DATE Oct. 16, '97 TAX MAP NO. part of 3FA24

OWNER OR CONTRACTOR A H Inc. PHONE: Business Watershed: ☑ Yes ☐ No

ADDRESS 2310 S. Main, Salisbury Home

LOCATION Cloverhill Rd. Turn on Ridgecreek Dr. on left

SUBDIVISION Rocky Creek BLOCK / SECTION LOT 10 LOT AREA 115'x200' SITE CLASS. RS DESIGN FLOW 480 gpd L.T.A.R. n.a.

Septic Tank: 1000 Gallons; STB 825 Date 10/19/97

Pump Tank: Gallons; PT Date

Pump Make: Model Serial No.

Nitrification Field: No Fields 1 Square Feet 536 Linear Feet 268

No Lines 4@67' Trench Width 24" Max Trench Bottom Depth 30" Gravel Depth N/A

☑ New System ☐ Repair System Type: I, II, III, IV, V, VI

System Description: gravity panel block

Repair System Description: same

Maintenance Agreement Required: ☐ Yes ☑ No

☐ House/Mod. Home No. Bedrooms #4

☑ Mobile Home SW No. Bathrooms 2

☐ Business No. Employees

☐ Other

☐ Slab ☑ Crawl Space ☐ Basement w/plumbing ☐ Basement wo/plumbing

Water Supply: ☑ Individual ☐ Community ☐ Public


Comments:

Comments:


No well on site 12/2/97

1"=50'

INITIAL SITE SKETCH

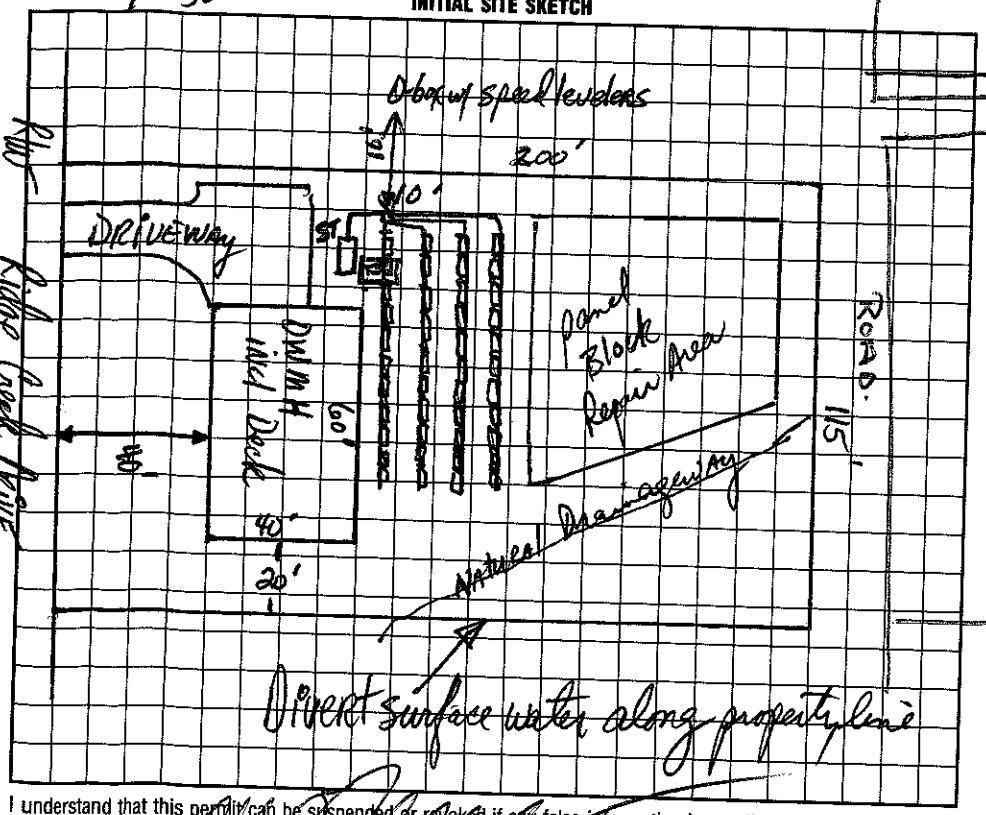

AS BUILT SKETCH

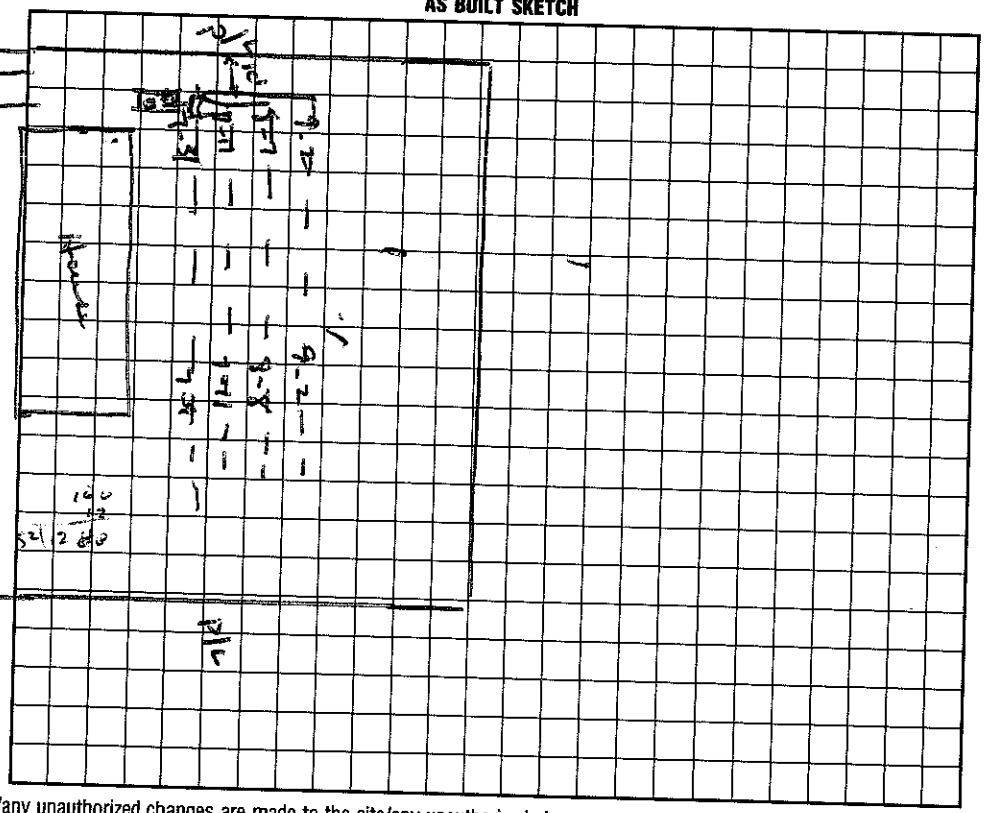

I understand that this permit can be suspended or revoked if any false information is supplied toward securing the permit/any unauthorized changes are made to the site/any unauthorized changes are made in the installation of the system. Improvement Permit is valid for 60 months from date of issuance.

Signed:

Improvement Permit by: RS date 10-16-97

~~Construction~~ Inspection by: RS date 10-16-97

Installed by: Rowan Septic Tank

Certificate of Completion by: Wesley Sparks RS date 12/2/97

Operation Permit by: Wesley Sparks R.S. date 12/2/97

HEALTH DEPT. COPY: WHITE INSPECTION COPY (FINAL): GREEN OWNER COPY (FINAL): YELLOW INSPECTION COPY (INITIAL): PINK OWNER COPY (INITIAL): GOLD