1:45

IREDELL COUNTY HEALTH DEPARTMENT

STATESVILLE 704-878-5305 MOORESVILLE 704-664-5281

IMPROVEMENT PERMIT / AUTHORIZATION TO CONSTRUCT / OPERATION PERMIT / EXISTING SYSTEM INSPECTION

PERMIT# 081185 PIN# 4740018684 DATE 8/17/99

OWNER OR CONTRACTOR AH Inc. PHONE: Business Home 704/855/1999

ADDRESS 240 Accetion Rd, China Grove NC 28069

LOCATION Perth, TL Clontz Hill, TR Ridge Ck, 7th on Left

SUBDIVISION Rocky River Creek BLOCK / SECTION LOT 9 LOT AREA .53 SITE CLASS. PS DESIGN FLOW 360 L.T.A.R. .3

Septic Tank: 1000 Gallons; STB 794 Date 7/5/99

Pump Tank: Gallons; PT Date

Pump Make: Model Serial No.

Nitrification Field: No Fields 1 Square Feet 1200 Linear Feet 400

No Lines 5@80' Trench Width 36 Max Trench Bottom Depth 36 Gravel Depth 12

☒ New System ☐ Repair System Type: I (II) III, IV, V, VI

System Description: Gravel/Conv.

Repair System Description: Gravel/Chamber

Maintenance Agreement Required: ☐ Yes ☒ No

☒ House/Mod. Home ☐ Mobile Home ☐ Business ☐ Other

No. Bedrooms 3 No. Bathrooms 2 No. Employees


☐ Slab ☒ Crawl Space ☐ Basement w/plumbing ☐ Basement wo/plumbing

Water Supply: ☒ Individual ☐ Public ☐ Community


Comments:/Conditions:

Comments:/Conditions:

INITIAL SITE SKETCH

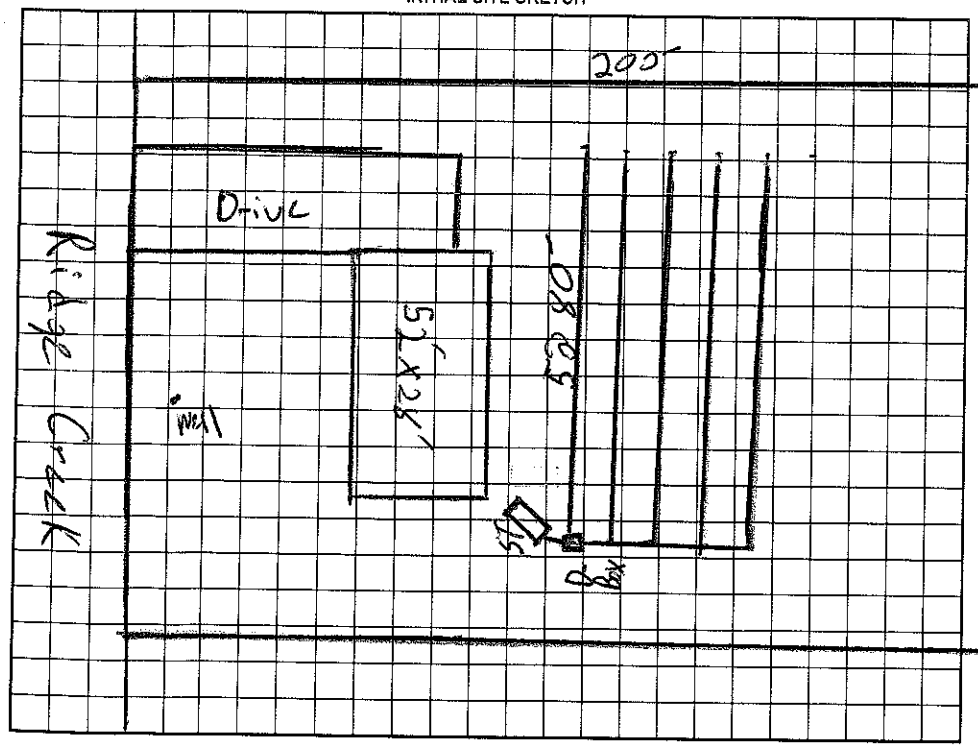

AS BUILT SKETCH

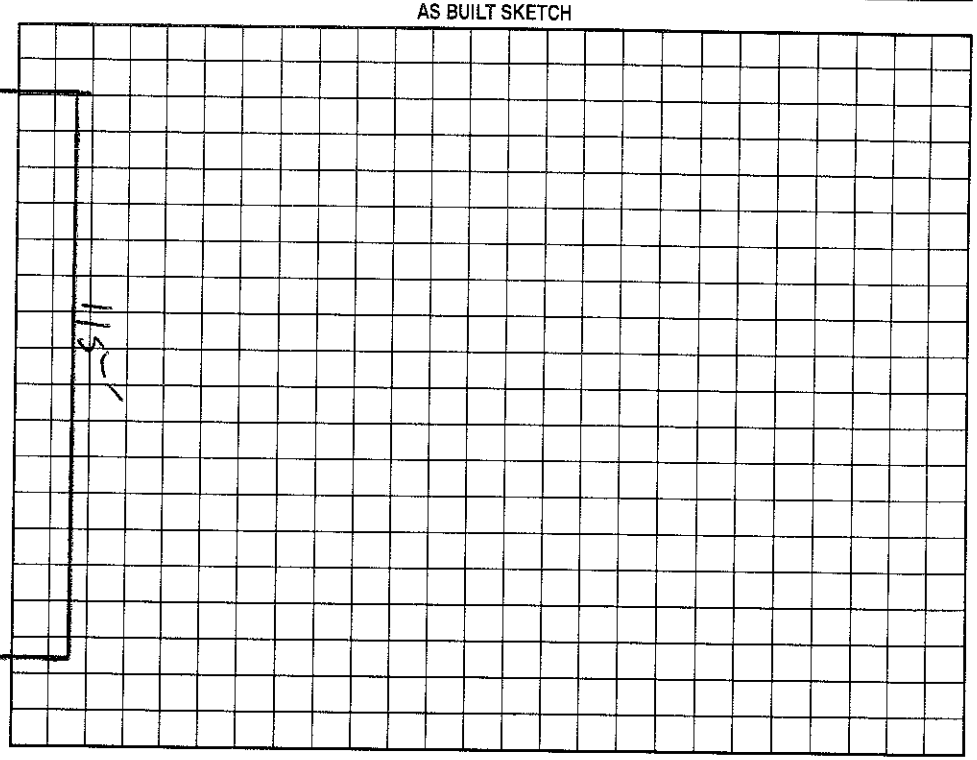

Permit can be suspended or revoked if any false information is supplied toward securing the permit/any unauthorized changes are made to the site/any unauthorized changes are made in the installation of the system. Improvement Permit with plat valid without expiration. Improvement Permit with site plan valid for sixty months. Authorization to Construct is valid for a period equal to that of Improvement Permit – not to exceed sixty months.

Signed: date

Improvement Permit by: Jeff Morgan date 8/17/99

Authorization to Construct by: Jeff Morgan date 8/17/99

Installed by: Tucker Septic

Operation Permit by: Jeff Morgan date 8/18/99

Existing System Inspection by: date

HEALTH DEPT. COPY: WHITE OWNER COPY (FINAL): YELLOW OWNER COPY (INITIAL): PINK