4:00

IREDELL COUNTY HEALTH DEPARTMENT

STATESVILLE 704-878-5305 MOORESVILLE 704-664-5281

IMPROVEMENT PERMIT / AUTHORIZATION TO CONSTRUCT / OPERATION PERMIT / EXISTING SYSTEM INSPECTION

PERMIT# 079484 PIN# 4740019230 DATE 2/18/99

OWNER OR CONTRACTOR AH INC PHONE: Business 855-2300 Home

ADDRESS 204 Auction Dr. Salisbury NC 28203

LOCATION Flower House, TR Clontz Hill, TL Rocky Ck, TR Brook

SUBDIVISION Rocky ~~Knob~~ Cove BLOCK / SECTION LOT 79 LOT AREA .68 SITE CLASS PS DESIGN FLOW 360 L.T.A.R. .3

Septic Tank: 1000 Gallons; STB 825 Date 3-2-99
Pump Tank: 1000 Gallons; PT ~~825~~ 2547 Date 3-17-99
Pump Make: Model Serial No.
Nitrification Field: No Fields 1 Square Feet 900 Linear Feet 300
No Lines 4@75' Trench Width 36" Max Trench Bottom Depth 36" Gravel Depth 12"

☑ New System ☐ Repair System Type: I, II, (III), IV, V, VI
System Description: Pump/Chamber Pressure Manifold
Repair System Description: 25% Redx/LPPanel
Maintenance Agreement Required: ☐ Yes ☐ No

☑ House/Mod. Home No. Bedrooms 3
☐ Mobile Home No. Bathrooms 2
☐ Business No. Employees
☐ Other
☐ Slab ☑ Crawl Space ☐ Basement w/plumbing ☐ Basement wo/plumbing


Water Supply: ☑ Individual ☐ Public ☐ Community

Comments:/Conditions: Keep septic 10' off PL & 5' off House
Keep septic 15' off of cut above house & off of left side PL cut.
Install septic lines on Contour


Comments:/Conditions: Keep septic on min of 50' off well
Installer changed to 4@75' for 300ft, instead of orig. 5@80 for 400ft o.K Jeff Morgan
Scale 1=50

1=50

INITIAL SITE SKETCH

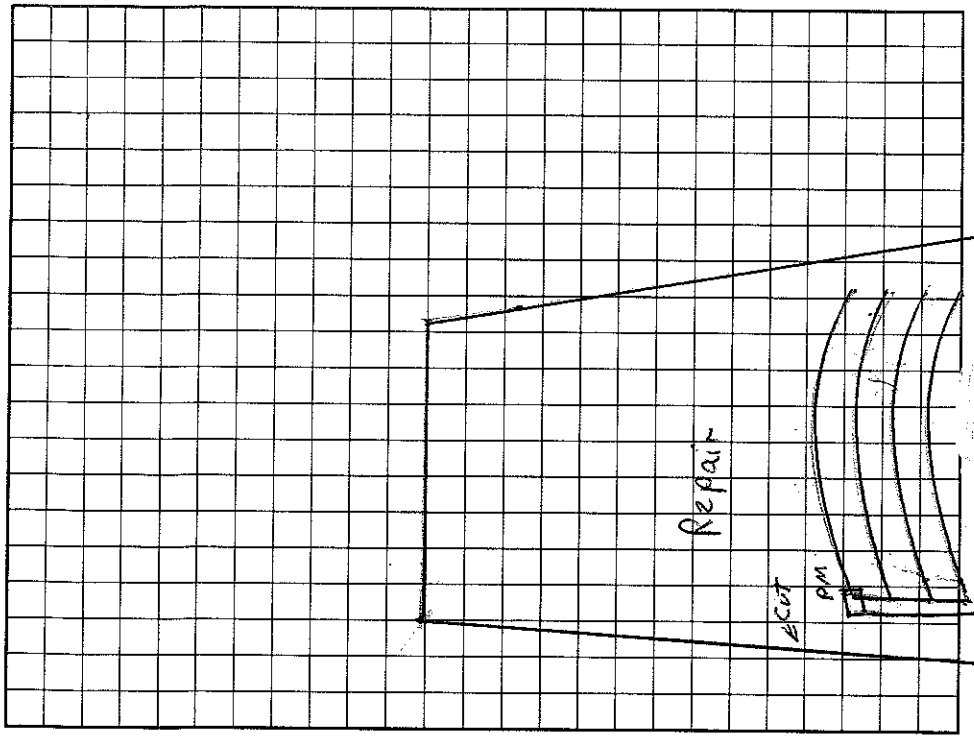

AS BUILT SKETCH

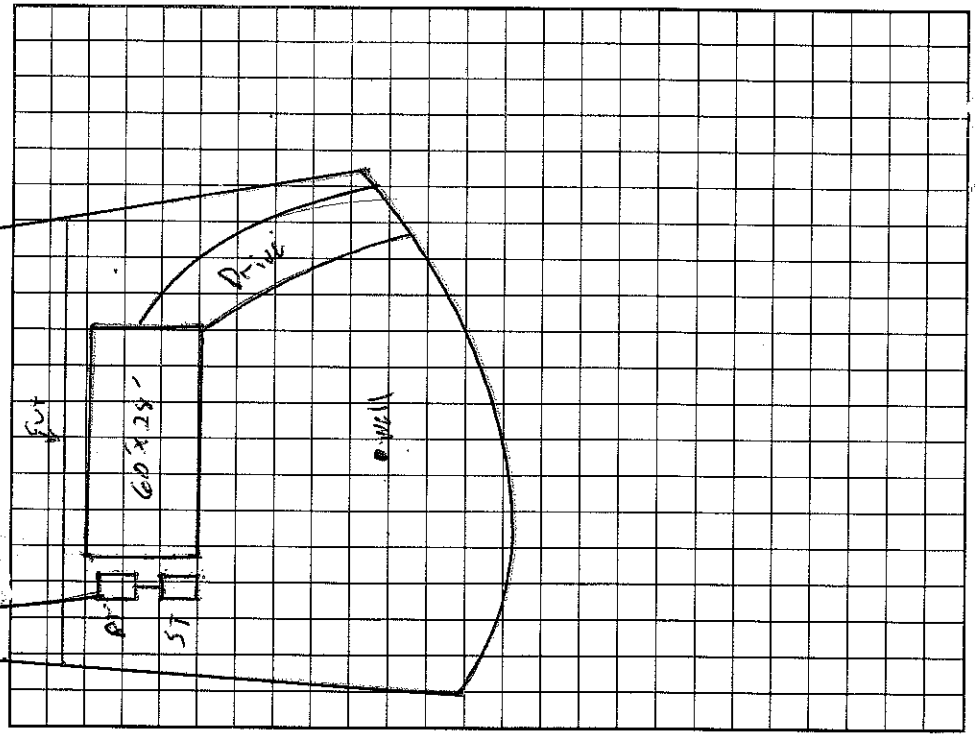

Permit can be suspended or revoked if any false information is supplied toward securing the permit/any unauthorized changes are made to the site/any unauthorized changes are made in the installation of the system. Improvement Permit with plat valid without expiration. Improvement Permit with site plan valid for sixty months. Authorization to Construct is valid for a period equal to that of Improvement Permit – not to exceed sixty months.

Signed: date 2-18-99 Installed by: Rowan Septic

Improvement Permit by: Jeff Morgan date 2/18/99 Operation Permit by: Jeff Morgan date 4/13/99

Authorization to Construct by: Jeff Morgan date 2/18/99 Existing System Inspection by: date

HEALTH DEPT. COPY: WHITE OWNER COPY (FINAL): YELLOW OWNER COPY (INITIAL): PINK