4740 03 1523

IREDELL COUNTY HEALTH DEPARTMENT

STATESVILLE 704-878-5305 MOORESVILLE 704-664-5281

IMPROVEMENT PERMIT / AUTHORIZATION TO CONSTRUCT / OPERATION PERMIT / EXISTING SYSTEM INSPECTION

PERMIT # 103446 PIN # 4740031523 DATE 10-20-2010

OWNER or APPLICANT Kelly Robinson PHONE: Business 704 902-1412 Home:

OWNER or APPLICANT ADDRESS 1157 Hamptons Cove Rd Troutman NC 28166

LOCATION / DIRECTIONS Perth Rd N TR Clontz Hill Rd. past Hamptons Cove property on left ½ mile #414

SUBDIVISION BLOCK / SECTION LOT # LOT AREA 13.52Ac DESIGN FLOW 480gpd L.T.A.R. .3

Septic Tank 1000 Gallons: STB 794 Date 8-26-11
Pump Tank Gallons: P T Date
Pump Make Model Serial #
Nitrification Field No Fields 1 No Lines 4 Linear Feet 400'
Trench Width 36" Max. Trench Bottom Depth 28" Gravel Depth N/A

☒ New System ☐ Repair ☐ Expansion System Type I II III IV V VI
System Description: Gravity -- 25% Reduction
Repair System Description: Same
Maintenance Agreement Required ☐ YES ☒ NO
☒ GRAVITY ☐ PRESSURE


☒ Residence No. Bedrooms 4
☐ Business No. Persons
☐ Other No. Employees
☐ Slab ☐ Crawl Space
☒ Basement w/plumbing ☐ Basement w/o plumbing

Water Supply: ☒ Private Exist. well ☐ Public ☐ Community

Comments / Conditions: Scale 1:100

Comments / Conditions: Installed Quick 4 As Drawn

INITIAL SITE SKETCH

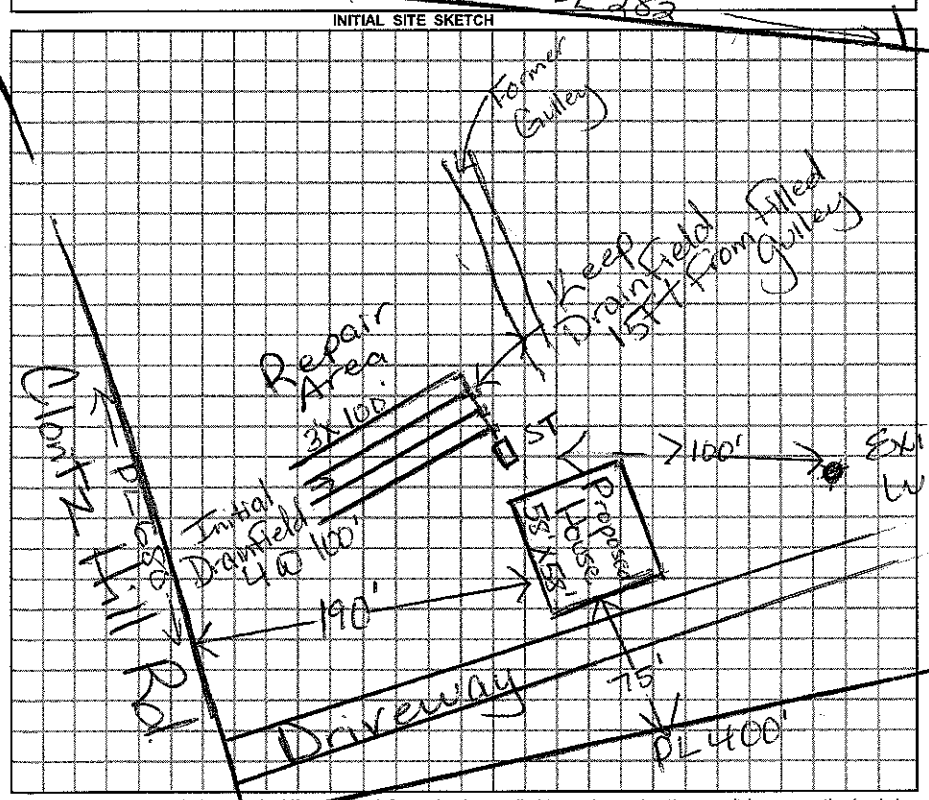

AS BUILT SKETCH

Permit can be suspended or revoked if any false information is supplied toward securing the permit / any unauthorized changes are made to the site / any unauthorized changes are made in the installation of the system.

☐ *IMPROVEMENT PERMIT w / plat valid without expiration.* ☐ *IMPROVEMENT PERMIT w / site plan valid for 60 mos.* ☐ *AUTHORIZATION TO CONSTRUCT valid for period equal to IMPROVEMENT PERMIT-not to exceed 60 mo.*

Owner / Applicant Signature: Kelly Robinson Date 10-25-10

Improvement Permit by: Maria H. Dotson RS Date 10/20/2010

Authorization to Construct by: Maria H. Dotson RS Date 10/20/2010

YOU SHOULD CONTACT A LOCATOR SERVICE PRIOR TO ANY EXCAVATION.

Installed by: C. Wayne Orbison

Operation Permit by: Maria H. Dotson RS Date: 10/6/2011

Existing System Inspected by: Date:

WHITE COPY Environmental Health YELLOW COPY (Final) Owner / Applicant PINK COPY (Initial) Owner / Applicant