IREDELL COUNTY HEALTH DEPARTMENT

STATESVILLE 704-878-5305 MOORESVILLE 704-664-5281

IMPROVEMENT PERMIT / AUTHORIZATION TO CONSTRUCT / OPERATION PERMIT / EXISTING SYSTEM INSPECTION

PERMIT# 145230 PIN# ~~4740108708~~ 4740 10 7706 ~~000~~ 72 DATE 10-01-07

OWNER OR APPLICANT Pilot Developers PHONE: Business 704-202-8449 Home

ADDRESS 2660 Ervin Rd Mooresville NC 28117

LOCATION 115 N TL Flowerhouse TL Clontz Hill TL Rocky Creek Cove TR Brook Creek Dr. on right

SUBDIVISION Rocky Creek Cove BLOCK / SECTION 1 LOT ~~72~~ 72 LOT AREA .83 Ac SITE CLASS PS DESIGN FLOW 360gpd L.T.A.R. .25 gpd/ft2

Septic Tank: 1000 Gallons: STB 825 Date 5/2/08

Pump Tank: Gallons: PT Date

Pump Make: Model Serial No.

Nitrification Field: No Fields 1 Square Feet 480 Linear Feet 240

No Lines 6 @ 40' Trench Width 24" min. Max Trench Bottom Depth 36"

☒ New System ☐ Repair ☐ Expansion System Type: I II III IV V VI

System Description: PPBPS gravity

Repair System Description: LP PPBPS

Maintenance Agreement Required: ☐ Yes ☒ No

Gravel Depth NA ☒ Gravity ☐ Pressure

☒ House/Mod. Home No. Bedrooms 3

☐ Mobile Home No. Persons 6

☐ Business No. Employees

☐ Other

Water Supply: ☒ Individual ☐ Public ☐ Community

☐ Slab ☒ Crawl Space ☐ Basement w/plumbing ☐ Basement wo/plumbing

Comments:/Conditions: 36" max.


Well shall be 100'+ from drainfield
Rake & Lime trench side walls
Flow splitters such as Zoeller

Comments:/Conditions:


Blue Fitter

1"=50'

INITIAL SITE SKETCH

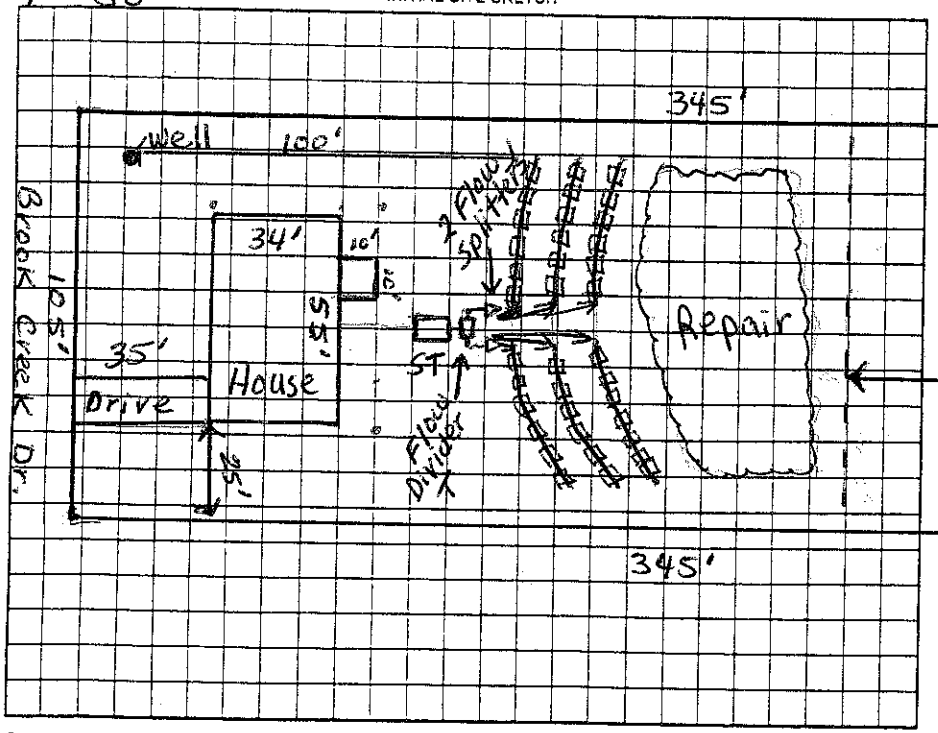

AS BUILT SKETCH

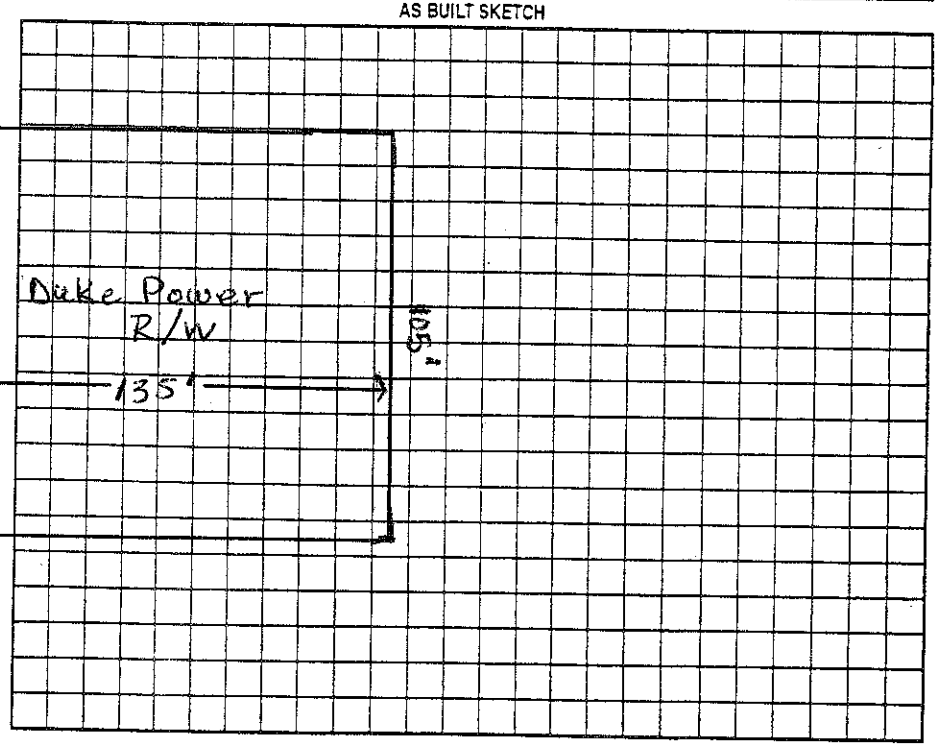

Permit can be suspended or revoked if any false information is supplied toward securing the permit/any unauthorized changes are made to the site/any unauthorized changes are made in the installation of the system. Improvement Permit with plat valid without expiration ☐ Improvement Permit with site plan valid for sixty months ☒ Authorization to Construct is valid for a period equal to that of Improvement Permit – not to exceed sixty months.

Signed: David Myers date 10-03-07 Installed by: Rowan

Improvement Permit by: Judy Melville date 10-01-07 Operation Permit by: date 6/19/08

Authorization to Construct by: Judy Melville date 10-01-07 Existing System Inspection by: date

HEALTH DEPT. COPY: WHITE OWNER COPY (FINAL): YELLOW OWNER COPY (INITIAL): PINK