2:00

# IREDELL COUNTY HEALTH DEPARTMENT

STATESVILLE 704-878-5305 MOORESVILLE 704-664-5281

## IMPROVEMENT PERMIT / AUTHORIZATION TO CONSTRUCT / OPERATION PERMIT / EXISTING SYSTEM INSPECTION

PERMIT# 145229 PIN# ~~4740888900.000~~ 4740108708 Lot 73 DATE 10/1/07

OWNER OR APPLICANT Rocky River LLC PHONE: Business 704 855-2300 Home

ADDRESS 450 Auction Dr. Salisbury NC 28147

LOCATION 150 to Perth Rd. TR Clontz Hill TR Rocky Creek Cove TR Brook Creek Dr. on ~~Left~~ Right

SUBDIVISION Rocky Creek Cove BLOCK / SECTION ph 1 LOT ~~74~~ 73 LOT AREA .83ac. SITE CLASS. PS DESIGN FLOW 360 L.T.A.R. .35

Septic Tank: 1000 Gallons: STB 825 Date 6/26/08

Pump Tank: Gallons: PT Date

Pump Make: Model Serial No.

Nitrification Field: No Fields 1 Square Feet 780 Linear Feet 260'

No Lines 3 Trench Width 36" Max Trench Bottom Depth 36"

☑ New System ☐ Repair ☐ Expansion System Type: I II III IV V VI

System Description: Gravity 25% Reduction

Repair System Description: Same

Maintenance Agreement Required: ☐ Yes ☑ No

☑ House/Mod. Home No. Bedrooms 3

☐ Mobile Home No. Persons

☐ Business No. Employees

☐ Other


Water Supply: ☑ Individual ☐ Public ☐ Community

Gravel Depth N/A ☑ Gravity ☐ Pressure ☐ Slab ☐ Crawl Space ☐ Basement w/plumbing ☐ Basement wo/plumbing


Comments:/Conditions: *use drop boxes or a DBox with equal distribution. 5/7 may be within 100' radius but no less than 50' from well Drainfield must be kept 100' from well.

Comments:/Conditions:

INITIAL SITE SKETCH

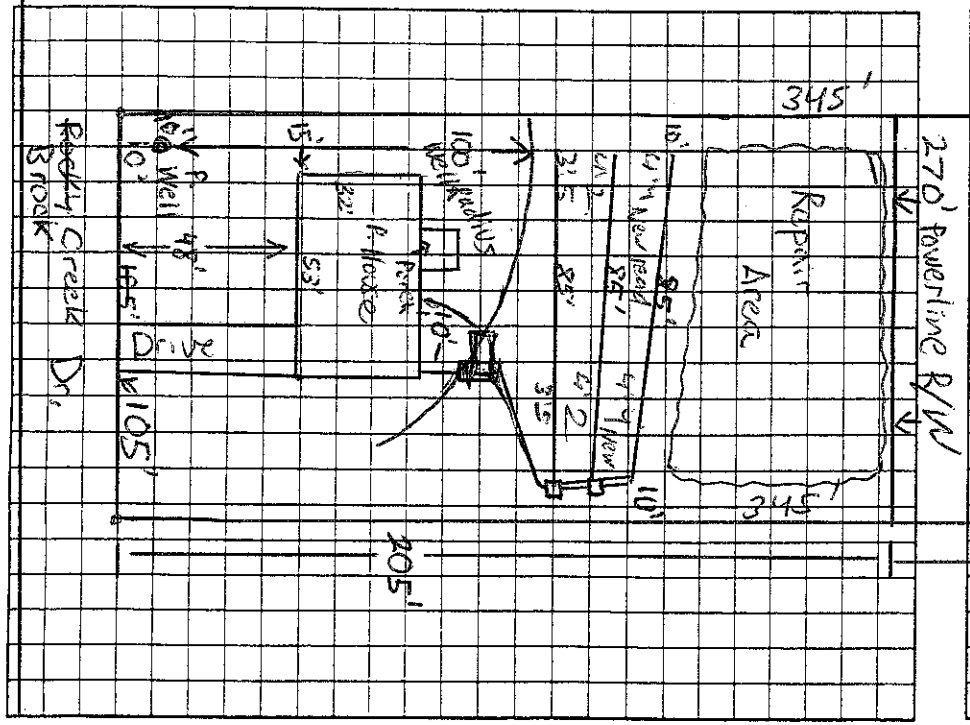


AS BUILT SKETCH

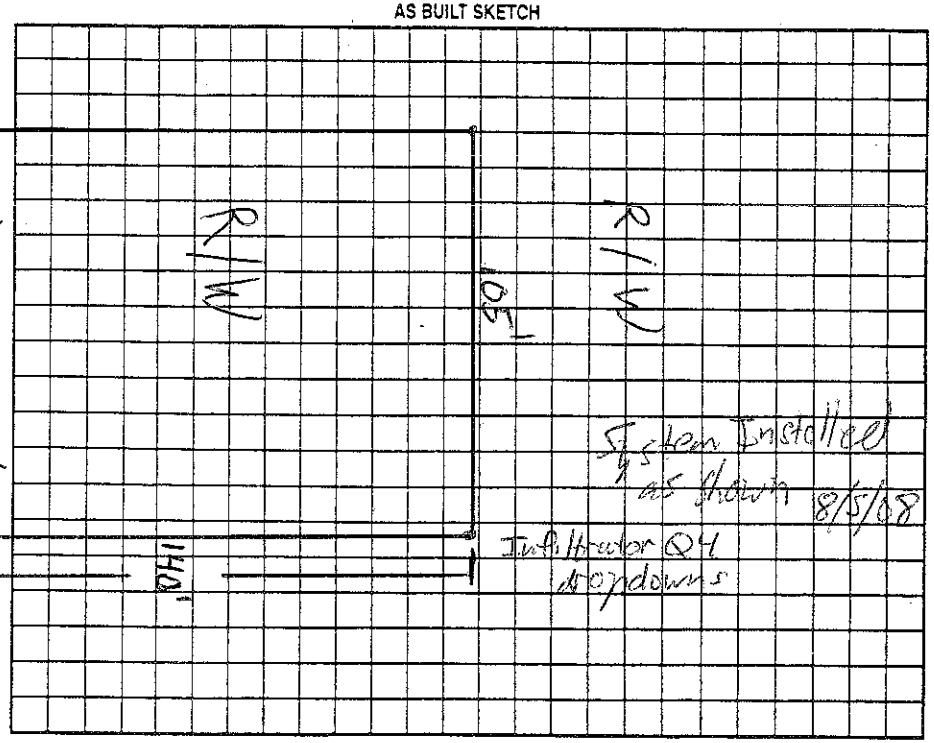


Permit can be suspended or revoked if any false information is supplied toward securing the permit/any unauthorized changes are made to the site/any unauthorized changes are made in the installation of the system. Improvement Permit with plat valid without expiration ☐ Improvement Permit with site plan valid for sixty months ☑ Authorization to Construct is valid for a period equal to that of Improvement Permit – not to exceed sixty months.

Signed: David Ryan Cobern date 10-3-07 Installed by: Rowan Septic

Improvement Permit by: Anthony Cohen Jr. date 10/1/07 Operation Permit by: Anthony Cohen Jr. date 8/5/08

Authorization to Construct by: Anthony Cohen Jr. date 10/1/07 Existing System Inspection by: date

HEALTH DEPT. COPY: WHITE OWNER COPY (FINAL): YELLOW OWNER COPY (INITIAL): PINK