IREDELL COUNTY HEALTH DEPARTMENT

STATESVILLE 704-878-5305 MOORESVILLE 704-664-5281

IMPROVEMENT PERMIT / AUTHORIZATION TO CONSTRUCT / OPERATION PERMIT / EXISTING SYSTEM INSPECTION

PERMIT# 145227 PIN# ~~4740209803.000~~ 4740108890 (66774) DATE 10/1/07

OWNER OR APPLICANT Rocky River LLC PHONE: Business 704 855-2300 Home

ADDRESS 450 Auction Dr. Salisbury NC 28147

LOCATION 150 to Perth Rd TR Clontz Hill Rd TR Rocky Creek Cove TR Brook Creek Dr on Right

SUBDIVISION Rocky Creek Cove BLOCK / SECTION ph 1 LOT ~~75~~ 74 LOT AREA .83 SITE CLASS. PS DESIGN FLOW 360 L.T.A.R. .3

Septic Tank: 1000 Gallons; STB ~~825~~ Date 2/6/08

Pump Tank: Gallons; PT Date

Pump Make: Model Serial No.

Nitrification Field: No. Fields 1 Square Feet 780' Linear Feet 260'

No Lines ~~8~~ 4 Trench Width 36" Max Trench Bottom Depth 36"

☑ New System ☐ Repair ☐ Expansion System Type: I II III IV V VI

System Description Gravity 25% Reduction

Repair System Description: LPP/BPS

Maintenance Agreement Required: ☐ Yes ☑ No Initial

Gravel Depth N/A ☑ Gravity ☐ Pressure

☑ House/Mod. Home No. Bedrooms 3

☐ Mobile Home No. Persons

☐ Business No. Employees

☐ Other


Water Supply: ☑ Individual ☐ Public ☐ Community

☐ Slab ☑ Crawl Space ☐ Basement w/plumbing ☐ Basement wo/plumbing


Comments:/Conditions: Use Drop boxes or a D-Box with flow levelers for equal distribution. * S/T may be within 100' well radius no less than 50', Drainfield must be 100' min from well.

Comments:/Conditions: IQ4XL - ENDCAP TO ENDCAP

INITIAL SITE SKETCH

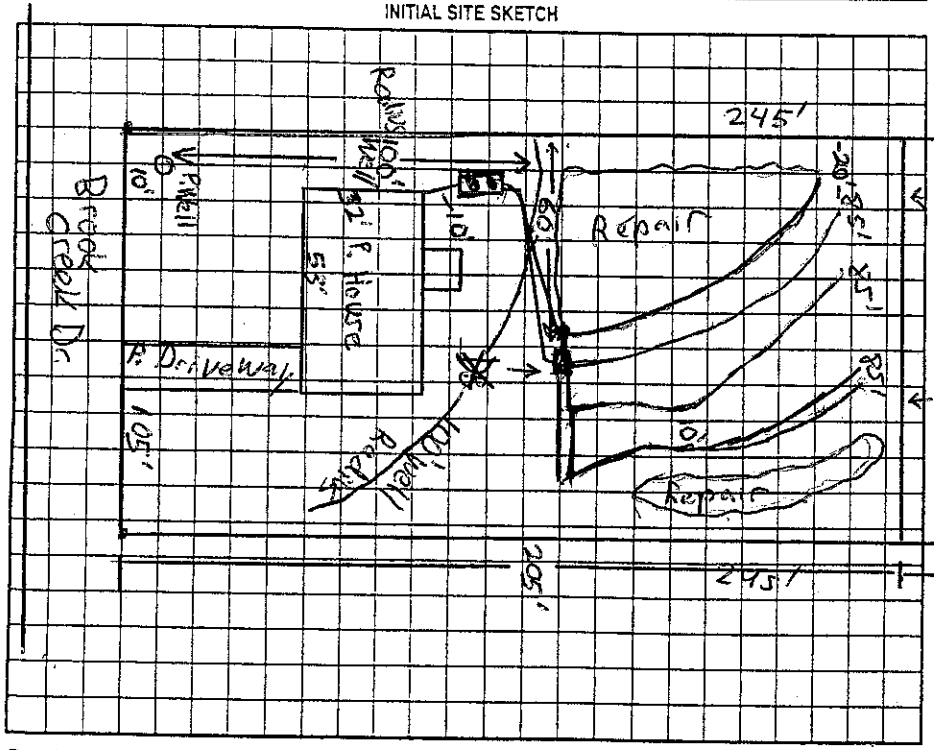

AS BUILT SKETCH

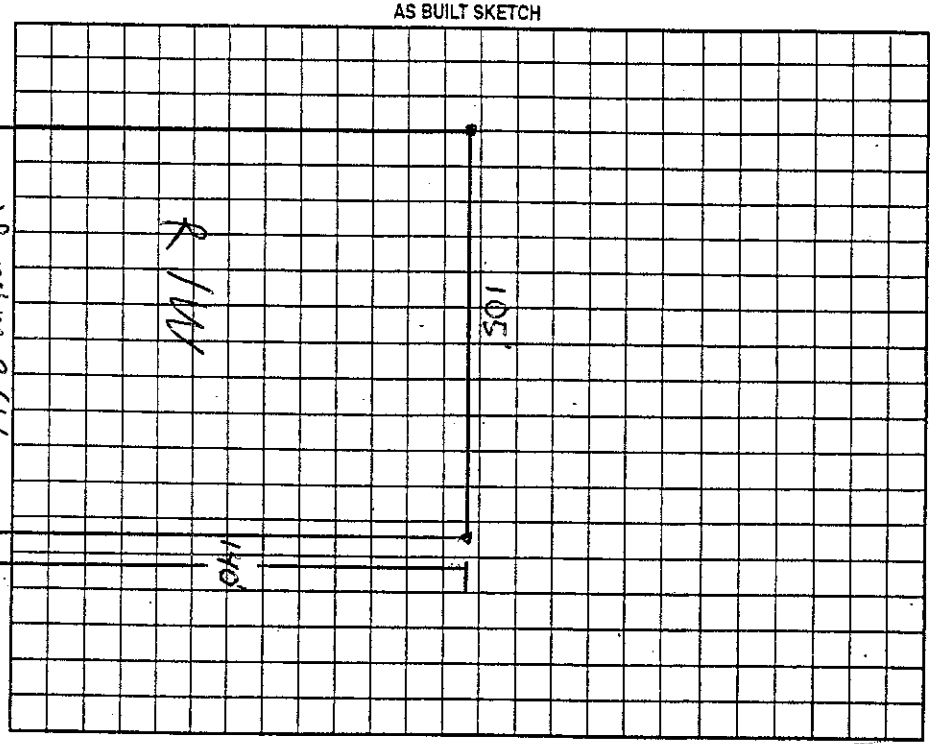

Permit can be suspended or revoked if any false information is supplied toward securing the permit/any unauthorized changes are made to the site/any unauthorized changes are made in the installation of the system. Improvement Permit with plat valid without expiration ☐ Improvement Permit with site plan valid for sixty months ☑ Authorization to Construct is valid for a period equal to that of Improvement Permit – not to exceed sixty months.

Signed: date 10/3/07

Improvement Permit by: Anthony Coker Jr. date 10/1/07

Authorization to Construct by: Anthony Coker Jr. date 10/1/07

Installed by: Rowan Septic Tank

Operation Permit by: Wesley Sparks R.S. date 3/27/08

Existing System Inspection by: date

HEALTH DEPT. COPY: WHITE OWNER COPY (FINAL): YELLOW OWNER COPY (INITIAL): PINK