IREDELL COUNTY HEALTH DEPARTMENT

Cust. Auth 4740-11-1307

STATESVILLE 704-878-5305 MOORESVILLE 704-664-5281

IMPROVEMENT PERMIT / ~~CERTIFICATE OF COMPLETION~~ / OPERATION PERMIT / EXISTING SYSTEM INSPECTION

PROPERTY DESCRIPTION NO. 21535 DATE Dec 3, '97 TAX MAP NO. part of 3FA24 Watershed ☐ Yes ☐ No

OWNER OR CONTRACTOR AH Inc. PHONE: Business Home

ADDRESS 2310 S. Main, Salisbury

LOCATION 150 OW Turnpath Rd N. TR Clontz Hill Rd bottom of hill TR Ridgecreek ~¼ mile on right

SUBDIVISION Rocky Creek Cove BLOCK / SECTION LOT 49 LOT AREA 110'x210' SITE CLASS. 5 DESIGN FLOW 360gpd L.T.A.R. n.3

Septic Tank: 1000 Gallons; STB 825 Date 10/14/97

Pump Tank: Gallons; PT Date

Pump Make: Model Serial No.

Nitrification Field: No Fields 1 Square Feet 900 Linear Feet 300

No Lines 3@100' Trench Width 36" Max Trench Bottom Depth 36" Gravel Depth N/A

☑ New System ☐ Repair System Type: I, II, III, IV, V, VI

System Description: Gravity Chambered / Has Similar

Repair System Description: OW/pumped panel block

Maintenance Agreement Required: ☐ Yes ☑ No

☐ House/Mod. Home No. Bedrooms 3

☑ Mobile Home DW No. Bathrooms 2

☐ Business No. Employees

☐ Other

☐ Slab ☑ Crawl Space ☐ Basement w/plumbing ☐ Basement wo/plumbing


Water Supply: ☑ Individual ☐ Community ☐ Public

Comments: Lot cut/graded and OW MH set up prior to issuance of I.P.


* ONE inspection/observation port per LATERAL

Comments:

INITIAL SITE SKETCH 1"=50'

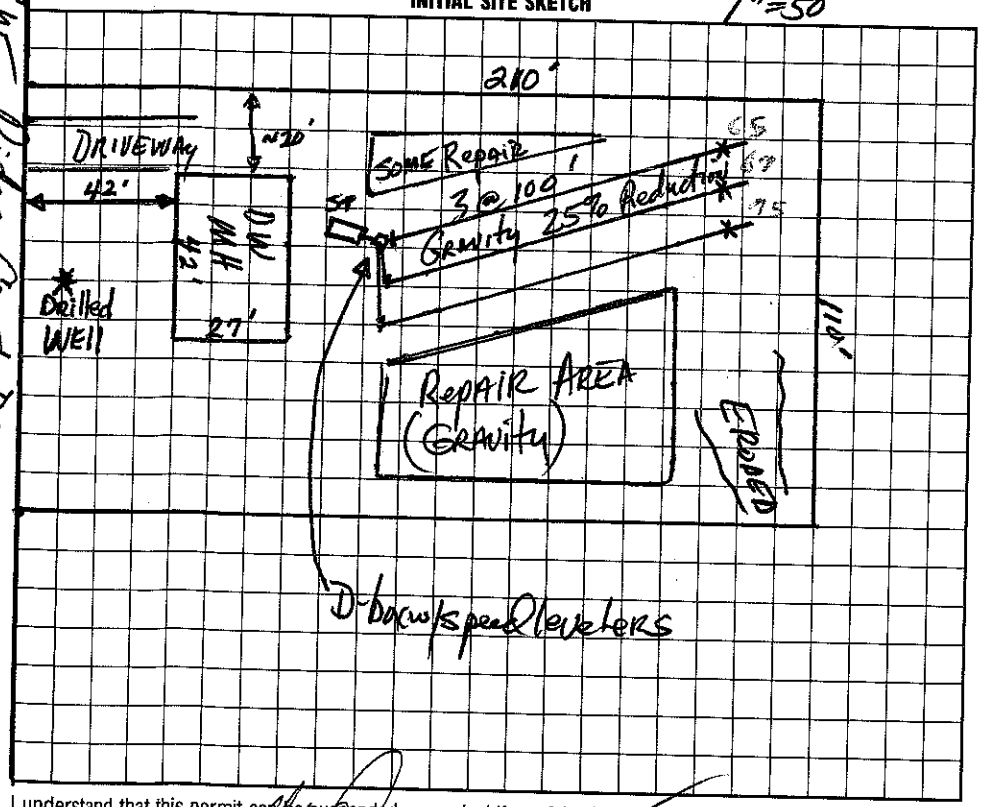

AS BUILT SKETCH

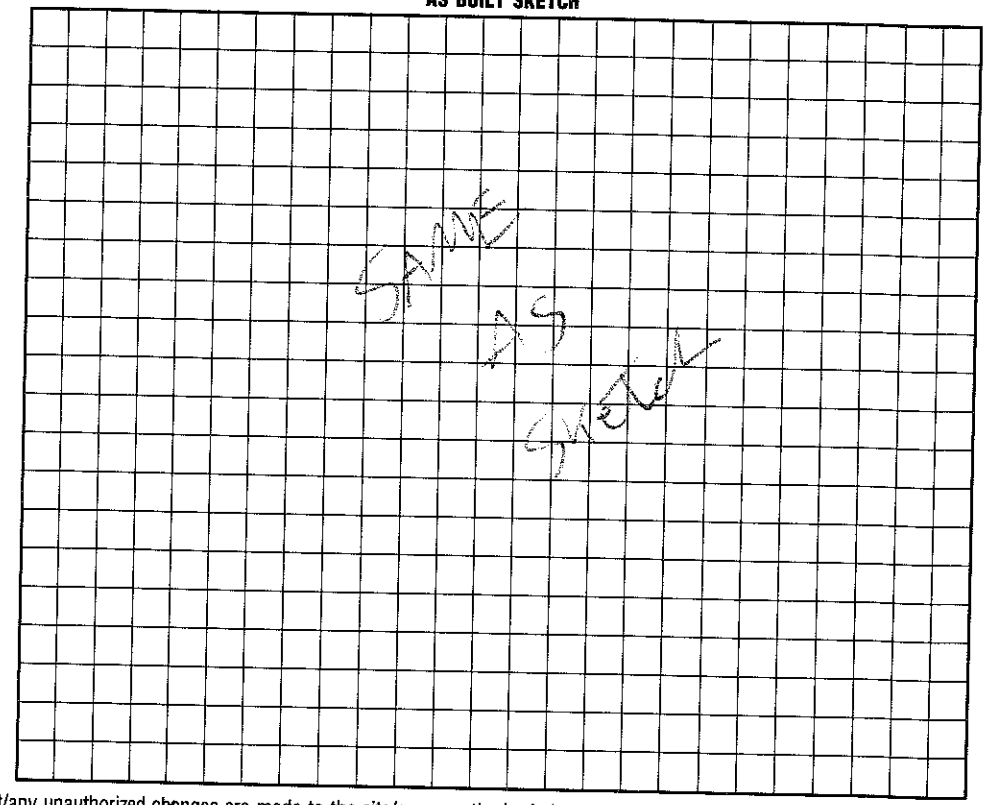

Rw Ridge Creek Dr.

I understand that this permit can be suspended or revoked if any false information is supplied toward securing the permit/any unauthorized changes are made to the site/any unauthorized changes are made in the installation of the system. Improvement Permit is valid for 60 months from date of issuance.

Signed: X

Improvement Permit by: DHoffman RS date 12-3-97

~~Construction/System Inspection by:~~ DHoffman IRS date 12-3-97

Installed by: Rowan Septic

Certificate of Completion by: date

Operation Permit by: date 12/8/97

HEALTH DEPT. COPY: WHITE INSPECTION COPY (FINAL): GREEN OWNER COPY (FINAL): YELLOW INSPECTION COPY (INITIAL): PINK OWNER COPY (INITIAL): GOLD