IREDELL COUNTY HEALTH DEPARTMENT

STATESVILLE 704-878-5305 130.00 Paid MOORESVILLE 704-664-5281

IMPROVEMENT PERMIT / AUTHORIZATION TO CONSTRUCT / OPERATION PERMIT / EXISTING SYSTEM INSPECTION

PERMIT# 112122 PIN# 4744011 2327 DATE 4-21-03

OWNER OR CONTRACTOR Piedmont Charlotte Developers PHONE: Business 883-9997 ~~Home~~ Jerry Smith 902 1836

ADDRESS 134 Koa Lane Statesville, NC 28677

LOCATION Hwy 21/115 North TL Flower House TL Clontz Hill Rd TL Bridge Creek 4th lot right past Brook Creek

SUBDIVISION Rocky Creek BLOCK / SECTION ____ LOT 48 LOT AREA .53 Acre SITE CLASS. PS DESIGN FLOW 480 gpd L.T.A.R. .31

Septic Tank: 1000 Gallons; STB 1012 Date 9-9-02
Pump Tank: ____ Gallons; PT ____ Date ____
Pump Make: ____ Model ____ Serial No. ____
Nitrification Field: No Fields 1 Square Feet 1200' Linear Feet 400'
No Lines 5 Trench Width 36" Max Trench Bottom Depth 36"

☒ New System ☐ Repair System Type: I, II, III, IV, V, VI
System Description: Gravity - 25% Reduction
Repair System Description: Gravity - Innovative
Maintenance Agreement Required: ☐ Yes ☒ No

☒ House/Mod. Home No. Bedrooms 4
☐ Mobile Home No. Bathrooms 2
☐ Business No. Employees ____
☐ Other ____


Water Supply: ☒ Individual ☐ Public ☐ Community

Gravel Depth N/A ☐ Slab ☐ Crawl Space ☐ Basement w/plumbing ☐ Basement wo/plumbing

Comments:/Conditions: Keep Septic System at least 10' From PL & 50-100' to any well.

Comments:/Conditions: Note: IF building pad is "cut down" then pump may be needed.

INITIAL SITE SKETCH Scale 1:50

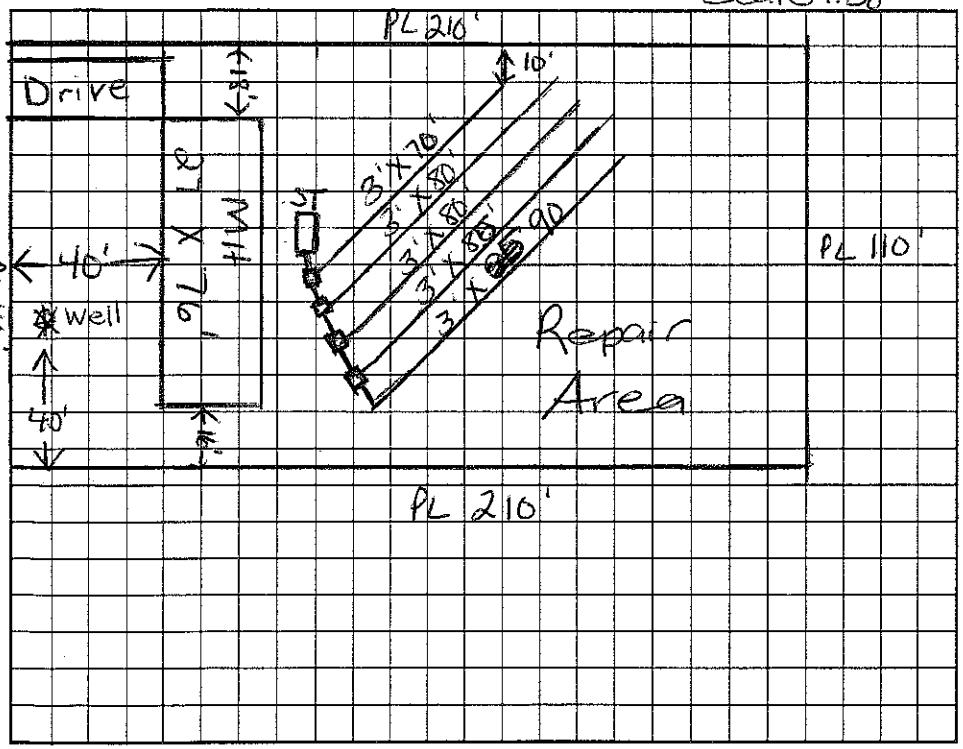

AS BUILT SKETCH

Installed as Drawn
Used "Plastic Chambers" Drainfield

Permit can be suspended or revoked if any false information is supplied toward securing the permit/any unauthorized changes are made to the site/any unauthorized changes are made in the installation of the system. Improvement Permit with plat valid without expiration. Improvement Permit with site plan valid for sixty months. Authorization to Construct is valid for a period equal to that of Improvement Permit – not to exceed sixty months.

Signed: Jerald Smith date 21 Apr. '03 Installed by: A-1 Backhoe

Improvement Permit by: Maria H. Dotson RS date 4/21/03 Operation Permit by: Maria H. Dotson RS date 4/28/03

Authorization to Construct by: Maria H. Dotson RS date 4/21/03 Existing System Inspection by: ____ date ____

HEALTH DEPT. COPY: WHITE OWNER COPY (FINAL): YELLOW OWNER COPY (INITIAL): PINK