IREDELL COUNTY HEALTH DEPARTMENT

STATESVILLE 704-878-5305 MOORESVILLE 704-664-5281

2130 -3' cm

IMPROVEMENT PERMIT / AUTHORIZATION TO CONSTRUCT / OPERATION PERMIT / EXISTING SYSTEM INSPECTION

PERMIT# 0883608 PIN# 4740114559 Allen 202-5234 DATE 6/13/2000

OWNER OR CONTRACTOR A. H Inc / Spears Construction PHONE: Business 855-2300 Home Max 202-4964

ADDRESS 450 Auction Dr / Salisbury NC 28147

LOCATION 1st Flower House Loop TL Goltz Hill TL Ridge Creek on left

SUBDIVISION Rocky Creek Cove BLOCK / SECTION ____ LOT 14 LOT AREA .53 Acre SITE CLASS PS DESIGN FLOW 360 gpd L.T.A.R. .3+

Septic Tank: 1000 Gallons; STB 825 Date 6/15/00

Pump Tank: ____ Gallons; PT ____ Date ____

Pump Make: ____ Model ____ Serial No. ____

Nitrification Field: No Fields 1 Square Feet 1200' Linear Feet 400'

No Lines 5 at 80' Trench Width 36" Max Trench Bottom Depth 36" Gravel Depth 12"

☒ New System ☐ Repair System Type: I, II, III, IV, V, VI

System Description: Gravity - Conventional

Repair System Description: Gravity - Innovative

Maintenance Agreement Required: ☐ Yes ☒ No

☒ House/Mod. Home ☐ Mobile Home ☐ Business ☐ Other

No. Bedrooms 3 No. Bathrooms 2 No. Employees ____


☒ Slab ☒ Crawl Space ☐ Basement w/plumbing ☐ Basement wo/plumbing

Water Supply: ☒ Individual ☐ Public ☐ Community

Comments:/Conditions: Keep Septic System 10' From PL & 5' From House & 100' to well from drainfield.

Comments:/Conditions: LINES ARE CLOSER TO HOUSE THAN DRAWING. THERE IS NO WAY TO STAY 100' FROM WELL WITHOUT GOING TO ALTERNATIVE/INNOVATIVE SYSTEM.

INITIAL SITE SKETCH Scale 1:50'

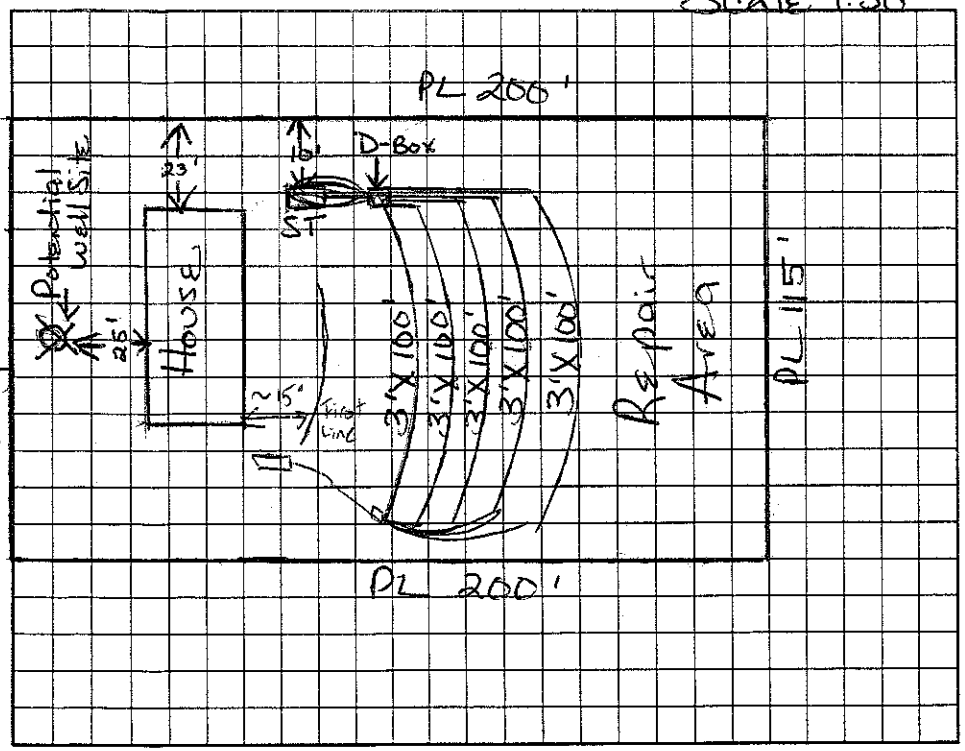

AS BUILT SKETCH

Permit can be suspended or revoked if any false information is supplied toward securing the permit/any unauthorized changes are made to the site/any unauthorized changes are made in the installation of the system. Improvement Permit with plat valid without expiration. Improvement Permit with site plan valid for sixty months. Authorization to Construct is valid for a period equal to that of Improvement Permit – not to exceed sixty months.

Signed: ____ date 6-14-00 Installed by: ROWAN SEPTIC

Improvement Permit by: Maria H. H. Dotson R.S. date 6/13/2000 Operation Permit by: C. by ____ R.S. date 8/1/00

Authorization to Construct by: Maria H. H. Dotson R.S. date 6/13/2000 Existing System Inspection by: ____ date ____

HEALTH DEPT. COPY: WHITE OWNER COPY (FINAL): YELLOW OWNER COPY (INITIAL): PINK