(4.00)

IREDELL COUNTY HEALTH DEPARTMENT

STATESVILLE 704-878-5305 MOORESVILLE 704-664-5281

IMPROVEMENT PERMIT / AUTHORIZATION TO CONSTRUCT / OPERATION PERMIT / EXISTING SYSTEM INSPECTION

PERMIT# 6306 PIN# 4740 11 7005 DATE 8/3/99

OWNER OR CONTRACTOR AH INC PHONE: Business 855-2300 Home

ADDRESS 450 AUCTION DR. STATESBURY NC 28146

LOCATION PERTHRD. TR CLONTZ HILL - TR RIDGE CREEK - TR BRADY CREEK. ON LT

SUBDIVISION ROCKY CREEK BLOCK / SECTION LOT 58 LOT AREA .63AC SITE CLASS. FS DESIGN FLOW 360 L.T.A.R. .3

Septic Tank: 1000 Gallons; STB 6295 Date 4/11/99

Pump Tank: 1000 Gallons; PT 47 Date 6/14/99

Pump Make: Model Serial No.

Nitrification Field: No Fields 1 Square Feet 1200 Linear Feet 400

No Lines 5 @ 80' Trench Width 36" Max Trench Bottom Depth 36" Gravel Depth 12"

☑ New System ☐ Repair System Type: I, II, III, IV, V, VI

System Description: PUMP CONVENTIONAL

Repair System Description: SAME

Maintenance Agreement Required: ☐ Yes ☑ No

☑ House/Mod. Home No. Bedrooms 3

☐ Mobile Home No. Bathrooms 2

☐ Business No. Employees

☐ Other

☐ Slab ☑ Crawl Space ☐ Basement w/plumbing ☐ Basement wo/plumbing


Water Supply: ☑ Individual ☐ Public ☐ Community

Comments:/Conditions:


Comments:/Conditions:

Electrical & Alarm checked 9/2/99 MD

INITIAL SITE SKETCH

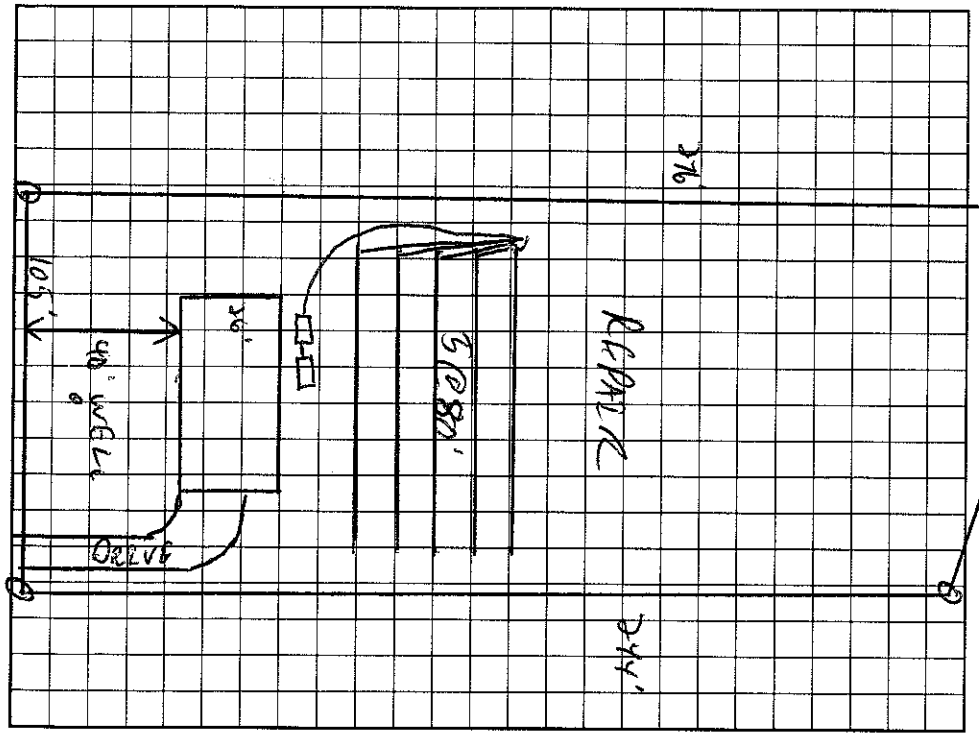

AS BUILT SKETCH

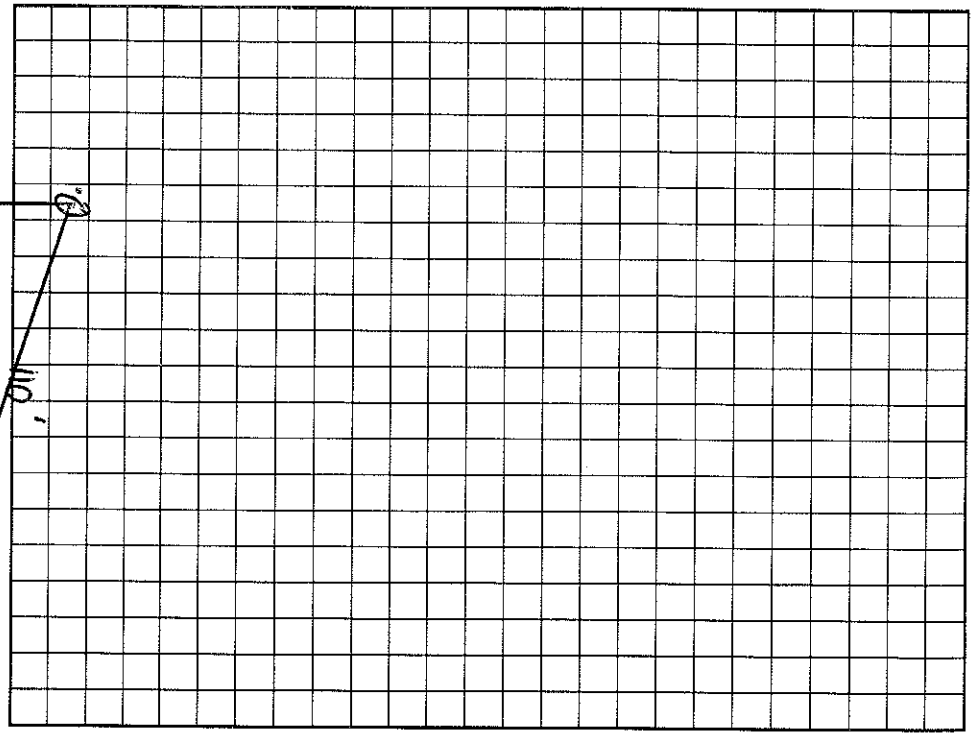

Permit can be suspended or revoked if any false information is supplied toward securing the permit/any unauthorized changes are made to the site/any unauthorized changes are made in the installation of the system. Improvement Permit with plat valid without expiration. Improvement Permit with site plan valid for sixty months. Authorization to Construct is valid for a period equal to that of Improvement Permit – not to exceed sixty months.

Signed: date 8-3-99 Installed by: ? TUCKER

Improvement Permit by: C. [illegible] ES date 8/3/99 Operation Permit by: Mark H. Dotson R.S. date 9/2/99

Authorization to Construct by: C. [illegible] ES date 8/3/99 Existing System Inspection by: date

HEALTH DEPT. COPY: WHITE OWNER COPY (FINAL): YELLOW OWNER COPY (INITIAL): PINK