IREDELL COUNTY HEALTH DEPARTMENT

STATESVILLE 704-878-5305 130.00 Pd MOORESVILLE 704-664-5281 2:00

IMPROVEMENT PERMIT / AUTHORIZATION TO CONSTRUCT / OPERATION PERMIT / EXISTING SYSTEM INSPECTION

PERMIT# 12012 PIN# 4740118016 Allen Mckinney DATE 6/24/04

OWNER OR CONTRACTOR Pilot Homes PHONE: Business 202-5234 Home

ADDRESS 450 Auction Drive Salisbury, NC 28144

LOCATION Perth Rd TR Clontz Hill TR Ridge Creek TR Brook Creek on left

SUBDIVISION Rocky Creek Cov BLOCK / SECTION LOT 89 LOT AREA .57 Acre SITE CLASS PS DESIGN FLOW 360gpd L.T.A.R. .3

Septic Tank: 1000 Gallons; STB 825 Date 9-30-04

Pump Tank: Gallons; PT Date

Pump Make: Model Serial No.

Nitrification Field: No Fields 1 Square Feet 900 Linear Feet 300

No Lines 5@60' Trench Width 36" Max Trench Bottom Depth 36" Gravel Depth N/A

☒ New System ☐ Repair System Type: I, II, III, IV, V, VI

System Description: Gravity - 25% Reduction

Repair System Description: Pump - LP - 25-50% Reduction

Maintenance Agreement Required: ☐ Yes ☒ No

☒ House/Mod. Home ☐ Mobile Home ☐ Business ☐ Other

No. Bedrooms 3 No. Bathrooms 2 No. Employees


☐ Slab ☐ Crawl Space ☐ Basement w/plumbing ☐ Basement wo/plumbing

Water Supply: ☒ Individual ☐ Public ☐ Community

Comments/Conditions: Keep Septic System at least 10' From PL & 50-100' to Well

Comments/Conditions: Set house, 15' From left Side line. Blue Flter installed Used 11 Plastic Chambers" Well installed in wrong spot, should still have 100% Repair

INITIAL SITE SKETCH Scale 1:50

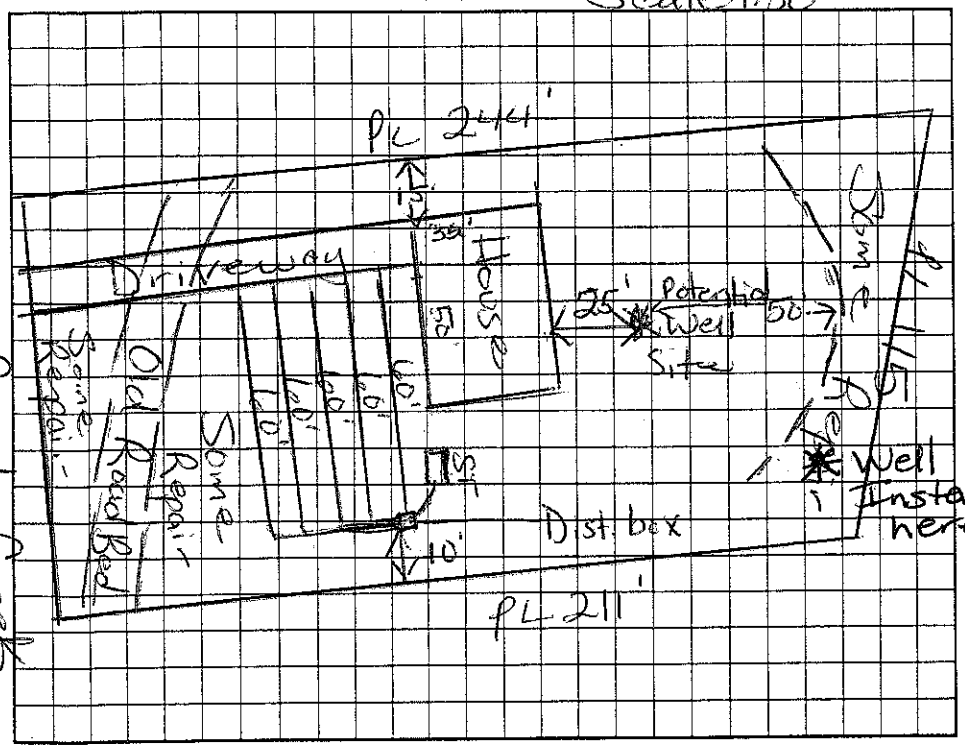

AS BUILT SKETCH

Speed levelers installed on 4 of 5 lines

Permit can be suspended or revoked if any false information is supplied toward securing the permit/any unauthorized changes are made to the site/any unauthorized changes are made in the installation of the system. Improvement Permit with plat valid without expiration. Improvement Permit with site plan valid for sixty months. Authorization to Construct is valid for a period equal to that of Improvement Permit – not to exceed sixty months.

Signed: date 8-23

Improvement Permit by: Maina H. Dotson RS date 6/25/04

Authorization to Construct by: Maina H. Dotson RS date 6/25/04

Installed by: Rowan Septic

Operation Permit by: Maina H. Dotson RS date 12/17/04

Existing System Inspection by: date

HEALTH DEPT. COPY: WHITE OWNER COPY (FINAL): YELLOW OWNER COPY (INITIAL): PINK