IREDELL COUNTY HEALTH DEPARTMENT

STATESVILLE 704-878-5305 MOORESVILLE 704-664-5281

IMPROVEMENT PERMIT / AUTHORIZATION TO CONSTRUCT / OPERATION PERMIT / EXISTING SYSTEM INSPECTION

PERMIT# 074306 PIN# 4740 17 7189 DATE 6-25-98

OWNER OR CONTRACTOR LEONARD BYERS PHONE: Business Home 528 9596

ADDRESS 346 BYERS ROAD TROUTMAN, NC 28166

LOCATION US 21 SOUTH TR BYERS ROAD AT END ON RIGHT

SUBDIVISION BLOCK / SECTION LOT LOT AREA ACREAGE SITE CLASS. PS DESIGN FLOW 100 L.T.A.R. 0.30 GPD/FT2

Septic Tank: 1000 Gallons; STB Date

Pump Tank: Gallons; PT Date

Pump Make: Model Serial No.

Nitrification Field: No Fields 1 Square Feet 330 Linear Feet 110'

No Lines TWO Trench Width 36" Max Trench Bottom Depth 36" Gravel Depth 12"

☑ New System ☐ Repair System Type: I, II, III, IV, V, VI

System Description: CONVENTIONAL GRAVITY

Repair System Description: CONV. GRAVITY

Maintenance Agreement Required: ☐ Yes ☑ No

☐ House/Mod. Home ☐ Mobile Home ☐ Business ☐ Other

No. Bedrooms No. Bathrooms 1 No. Employees 3


☑ Slab ☐ Crawl Space ☐ Basement w/plumbing ☐ Basement wo/plumbing

Water Supply: ☑ Individual ☐ Public ☐ Community WELL


Comments:/Conditions:

Comments:/Conditions:

INITIAL SITE SKETCH SCALE: 1" = 50'

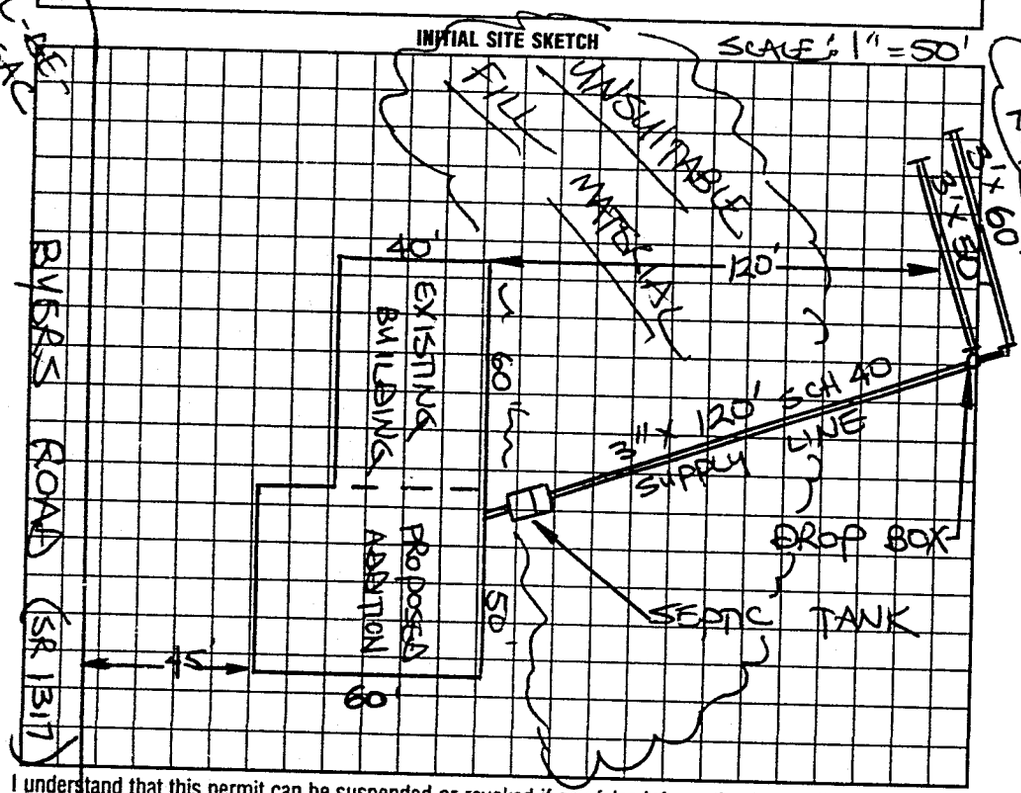

AS BUILT SKETCH

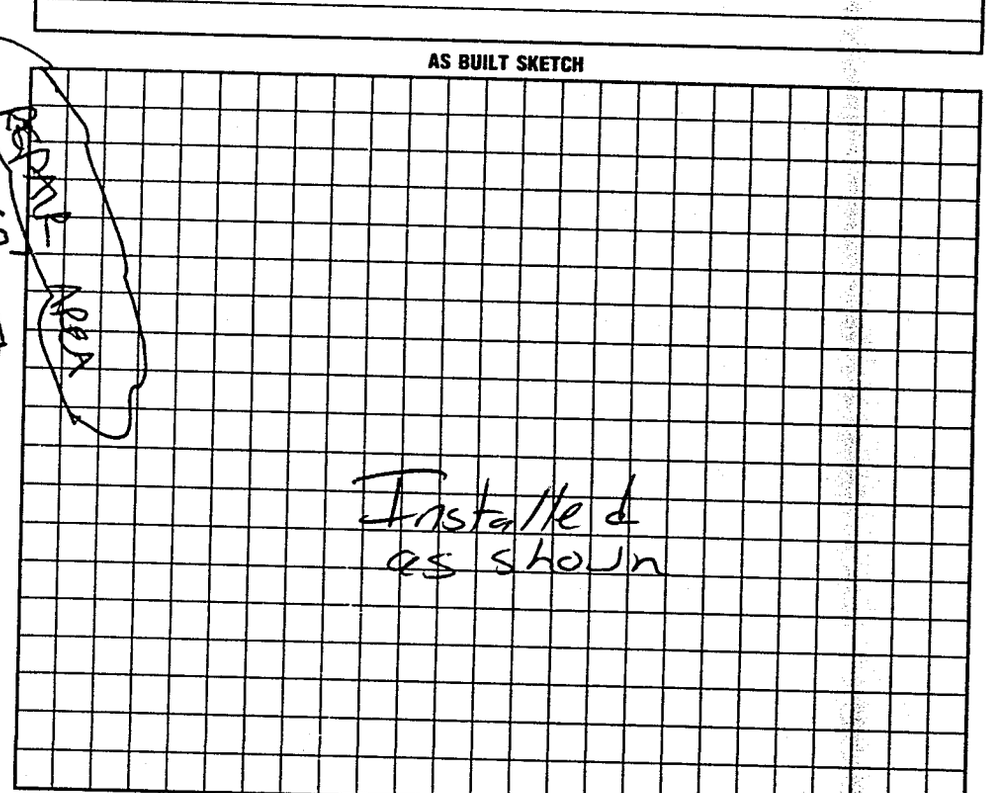

I understand that this permit can be suspended or revoked if any false information is supplied toward securing the permit/any unauthorized changes are made to the site/any unauthorized changes are made in the installation of the system. Improvement Permit with plat valid without expiration. Improvement Permit with site plan valid for sixty months. Authorization to Construct is valid for a period equal to that of Improvement Permit – not to exceed sixty months.

Signed: + Wayne Hendrix date 6-25-98 Installed by: James Hudler

Improvement Permit by: STEVE HEDRICK date 6-25-98 Operation Permit by: Mark Collins date 8-10-98

Authorization to Construct by: STEVE HEDRICK date 6-25-98 Existing System Inspection by: date

HEALTH DEPT. COPY: WHITE INSPECTION COPY (FINAL): GREEN OWNER COPY (FINAL): YELLOW INSPECTION COPY (INITIAL): PINK OWNER COPY (INITIAL): GOLD