IREDELL COUNTY HEALTH DEPARTMENT

Statesville Phone TR 3-7271 Mooresville Phone NO 3-1271

PERMIT TO INSTALL SEPTIC TANK

Permit NO. _____ Permit Date April 24 1969

Owner Jay C. Byers Address R 1 Troutman Box 213

Installed By C Hoke & Sons Address R 7 Statesville


Location of Property 21 South - dirt to Right before St. Michel Cem. last on L end of Rd.

Tank		Capacity		Length of Lines		Fixtures	
Block	( )	1000	( )	225'	(✓)	No. of Baths	(1)
Precast	(✓)	1250	( )	250'	( )	Dishwasher	( )
Lock		1500	( )	Other _____		Garbage Grdr.	( )
		Other _____				Other _____	

NOTIFY HEALTH DEPARTMENT AT LEAST EIGHT HOURS BEFORE TANK IS TO BE INSPECTED.

Final Inspection _____ 19___ Approved ( ) Disapproved ( )

Remarks well 52' - well underground not locatable took reading from where owner and builder says located. 52 ft. to drain field - Very steep hillside - soil seems to be good.

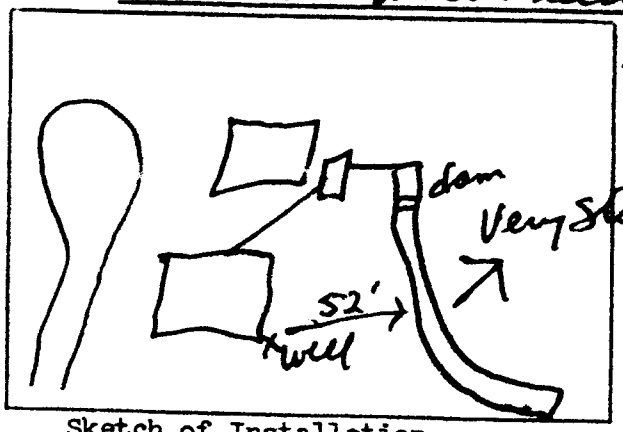

Sketch of Installation

Sanitarian