IREDELL COUNTY HEALTH DEPARTMENT

STATESVILLE 704-878-5305 MOORESVILLE 704-664-5281

IMPROVEMENT PERMIT / AUTHORIZATION TO CONSTRUCT / OPERATION PERMIT / EXISTING SYSTEM INSPECTION

PERMIT# 91126 PIN# ~~4740203493 PT~~ 4740 20 3233 DATE 4/26/01

OWNER OR CONTRACTOR ~~A H Fore~~ William Lincoln PHONE: Business 704 636 7765 Home

ADDRESS 2310 S Main St, Salisbury NC 28147

LOCATION Perth, R Clontz Hill, R Ridge Crk, R Wiltshire, L Panthers Crk, L Coguina, on Lt, 2nd Lo

SUBDIVISION Wiltshire Crk BLOCK / SECTION LOT 8 LOT AREA 0.764 SITE CLASS. 15 DESIGN FLOW 360 L.T.A.R. 0.3

Septic Tank: 1000 Gallons: STB 825 Date 3/20/01

Pump Tank: Gallons: PT Date

Pump Make: Model Serial No.

Nitrification Field: No Fields 1 Square Feet 1200 Linear Feet 400

No Lines 4 @ 100' Trench Width 36" Max Trench Bottom Depth 36"

☒ New System ☐ Repair System Type: I (II) III. IV. V. VI

System Description: Gravity Conventional

Repair System Description: Scale 25-50%

Maintenance Agreement Required: ☐ Yes ☒ No Reduction

Gravel Depth 12" ☐ Slab ☒ Crawl Space ☐ Basement w/plumbing ☐ Basement wo/plumbing

☒ House/Mod. Home No. Bedrooms 3

☐ Mobile Home No. Bathrooms 2

☐ Business No. Employees


☐ Other

Water Supply: ☒ Individual ☐ Public ☐ Community

Comments:/Conditions:

Comments:/Conditions:

INITIAL SITE SKETCH Scale 1:50

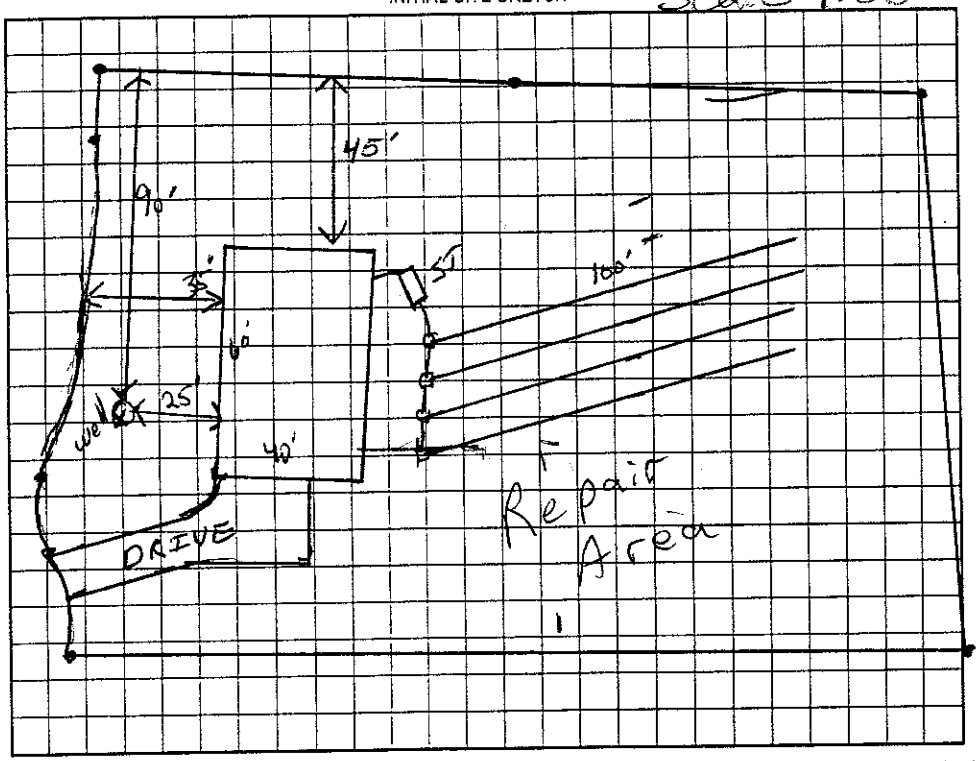

AS BUILT SKETCH

The proposed / existing Above ground Pool addition does not appear to impact the existing septic system.

**NOTE: Additional repair will be needed above existing Septic. Marina Dotson R.S.

Repair 25%-50% reduction

Date: 7/7/09

ICHD-Environmental Health Division

Stay 15FT from exist. Septic

Permit can be suspended or revoked if any false information is supplied toward securing the permit/any unauthorized changes are made to the site/any unauthorized changes are made in the installation of the system. Improvement Permit with plat valid without expiration. Improvement Permit with site plan valid for sixty months. Authorization to Construct is valid for a period equal to that of Improvement Permit – not to exceed sixty months.

Signed: date 5/16/01

Improvement Permit by: RSE date 4/26/01

Authorization to Construct by: RSE date 4/26/01

Installed by: Rowan Septic Tank

Operation Permit by: Wesley Sparks R.S. date 7/19/01

Existing System Inspection by: date

OWNER COPY (FINAL) YELLOW OWNER COPY (INITIAL) PINK