25.00 Paid 21 30

IREDELL COUNTY HEALTH DEPARTMENT

STATESV 704-878-5305 MOORESVILLE 704-664-5281

IMPROVEMENT PERMIT / AUTHORIZATION TO CONSTRUCT / OPERATION PERMIT / EXISTING SYSTEM INSPECTION

PERMIT# 090658-109908 PIN# ~~4740-20-3493~~ 4740208230 DATE 1/21/03

OWNER OR CONTRACTOR A H Inc PHONE: Business 704-202-5234 Home

ADDRESS 450 Auction Dr Salisbury NC 28147

LOCATION North, TR Cloverhill, TR Ridge Crk, TR Wiltshire, TL Panther Crk, on Corner

SUBDIVISION Wiltshire Crk BLOCK / SECTION LOT 4 LOT AREA 0.55 AC SITE CLASS. PS DESIGN FLOW 360 L.T.A.R. 0.3

Septic Tank: 1000 Gallons; STB 825 Date 1-6-03

Pump Tank: Gallons; PT Date

Pump Make: Model Serial No.

Nitrification Field: No Fields 1 Square Feet 1200 Linear Feet 460

No Lines 5 @ 80' Trench Width 36" Max Trench Bottom Depth 36" Gravel Depth 12"

☒ New System ☐ Repair System Type: I, (II), III, IV, V, VI

System Description: Gravity Conventional

Repair System Description: 25% Reduction

Maintenance Agreement Required: ☐ Yes ☒ No

☒ House/Mod. Home ☐ Mobile Home ☐ Business ☐ Other

No. Bedrooms 3 No. Bathrooms 2 No. Employees


☒ Slab ☐ Crawl Space ☐ Basement w/plumbing ☐ Basement wo/plumbing

Water Supply: ☒ Individual ☐ Public ☐ Community

Comments:/Conditions:

Comments:/Conditions: Blue filter installed

INITIAL SITE SKETCH

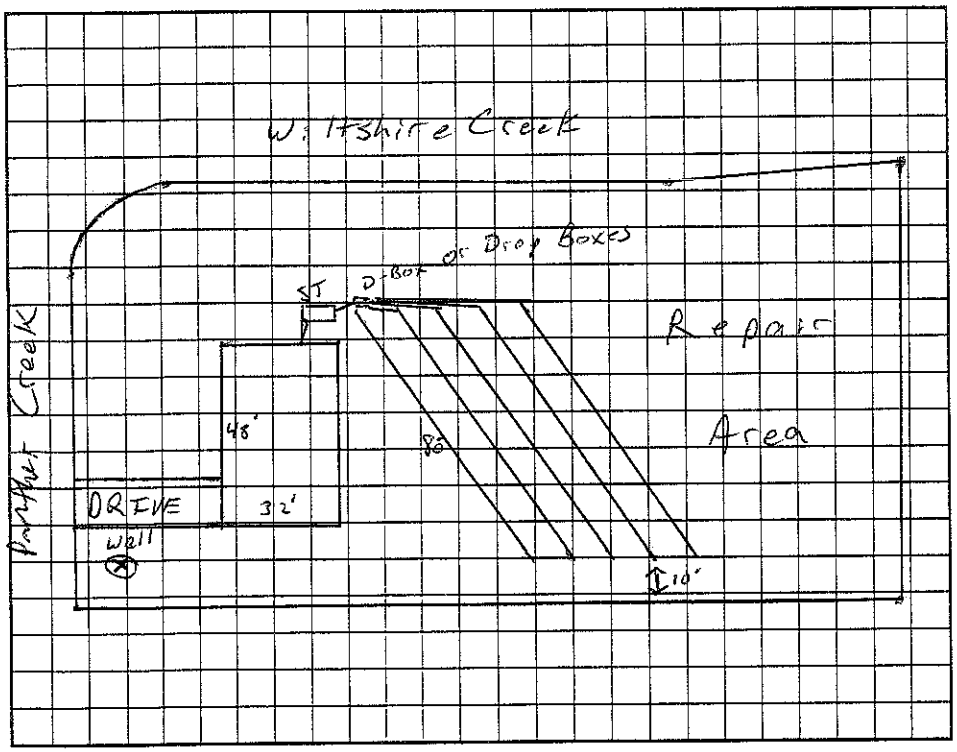

AS BUILT SKETCH

Installed Conventional System as Drawn
Used Drop boxes

Permit can be suspended or revoked if any false information is supplied toward securing the permit/any unauthorized changes are made to the site/any unauthorized changes are made in the installation of the system. Improvement Permit with plat valid without expiration. Improvement Permit with site plan valid for sixty months. Authorization to Construct is valid for a period equal to that of Improvement Permit – not to exceed sixty months.

Signed: date 1/21/03 Installed by: Rowan Septic

Improvement Permit by: RS date 1/21/03 Operation Permit by: RS date 3/10/03

Authorization to Construct by: RS date 1/21/03 Existing System Inspection by: date

HEALTH DEPT. COPY: WHITE OWNER COPY (FINAL): YELLOW OWNER COPY (INITIAL): PINK