IREDELL COUNTY HEALTH DEPARTMENT

STATESVILLE 704-878-5305 2500 Paid MOORESVILLE 704-664-5281

IMPROVEMENT PERMIT / AUTHORIZATION TO CONSTRUCT / OPERATION PERMIT / EXISTING SYSTEM INSPECTION

PERMIT# 09123 PIN# ~~4740203493 PT~~ 4740208388 DATE 9/5/03

OWNER OR CONTRACTOR A H Inc. PHONE: Business 704-202-5234 Home

ADDRESS 450 Auction Dr. Salisbury NC 28147

LOCATION Perth, TR Clontz Hill, TR Ridge Crk, TR Wiltshire on Lt Near end

SUBDIVISION Wiltshire Crk BLOCK / SECTION LOT 3 LOT AREA 0.71 AC SITE CLASS PS DESIGN FLOW 360 L.T.A.R. 0.3

Septic Tank: 1000 Gallons; STB 825 Date 9/16/03
Pump Tank: Gallons; PT Date
Pump Make: Model Serial No.
Nitrification Field: No Fields 1 Square Feet 1200 Linear Feet 400
No Lines 4 Trench Width 36" Max Trench Bottom Depth 36" Gravel Depth 12"

☒ New System ☐ Repair System Type: I, II, III, IV, V, VI
System Description: Gravity Conventional
Repair System Description: Gravity 25% Reduction
Maintenance Agreement Required: ☐ Yes ☒ No


☒ House/Mod. Home No. Bedrooms 3
☐ Mobile Home No. Bathrooms 2
☐ Business No. Employees
☐ Other
☐ Slab ☒ Crawl Space ☐ Basement w/plumbing ☐ Basement wo/plumbing

Water Supply: ☒ Individual ☐ Public ☐ Community


Comments:/Conditions:

Comments:/Conditions:

INITIAL SITE SKETCH

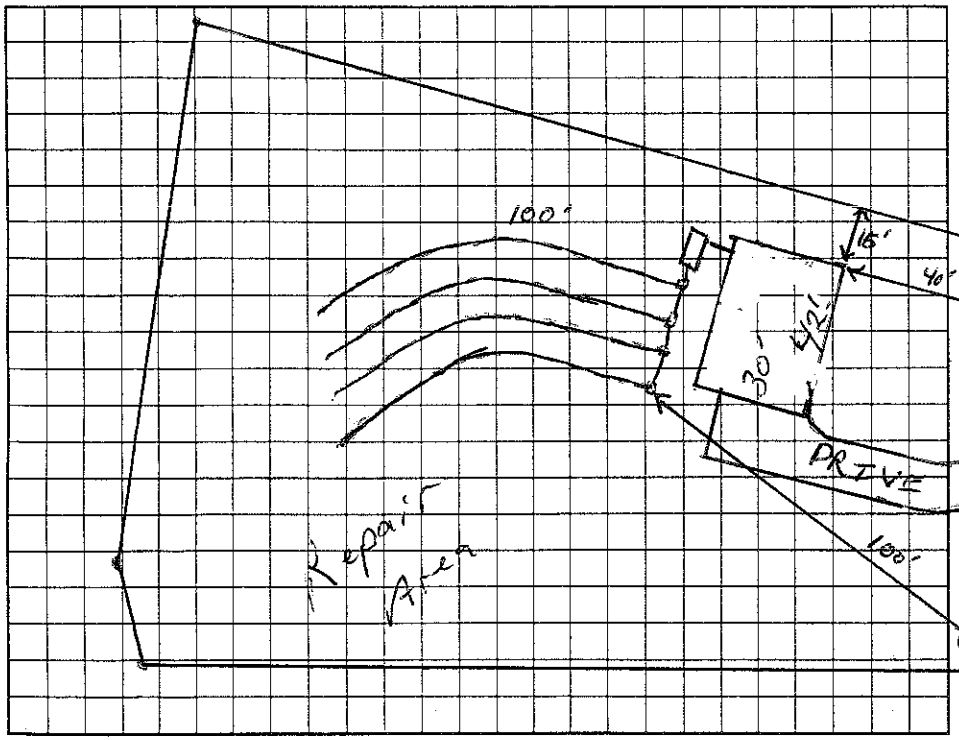

AS BUILT SKETCH

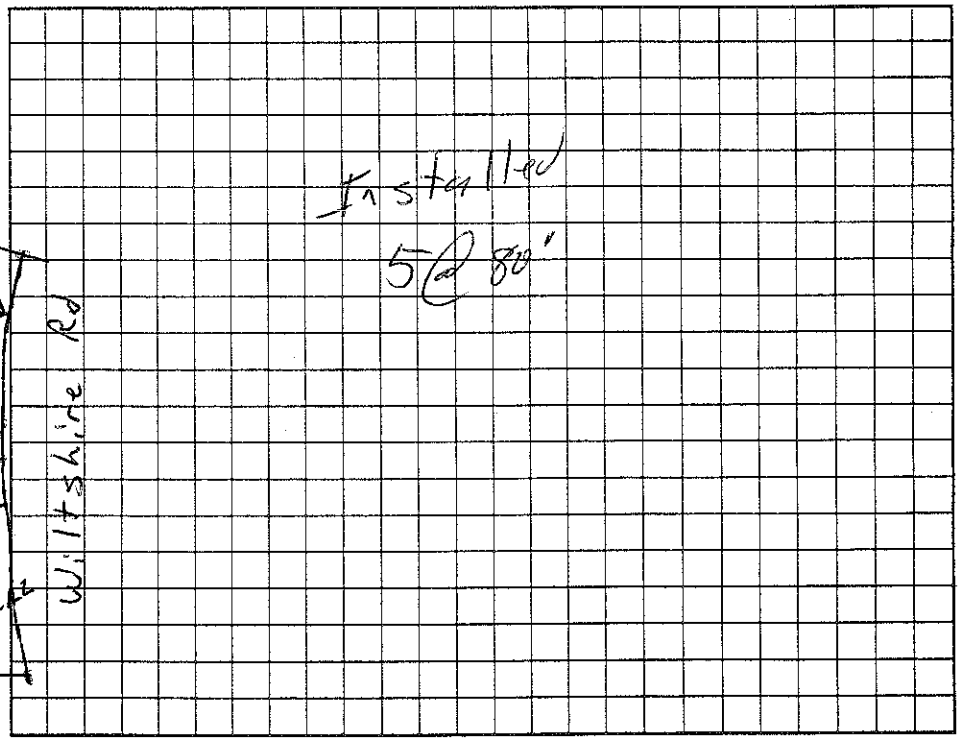

Permit can be suspended or revoked if any false information is supplied toward securing the permit/any unauthorized changes are made to the site/any unauthorized changes are made in the installation of the system. Improvement Permit with plat valid without expiration. Improvement Permit with site plan valid for sixty months. Authorization to Construct is valid for a period equal to that of Improvement Permit – not to exceed sixty months.

Signed: Julia Carter date 9/22/03 Installed by: Rowan Septic

Improvement Permit by: RS date 9/5/03 Operation Permit by: RS date 11/13/03

Authorization to Construct by: RS date 9/5/03 Existing System Inspection by: date

HEALTH DEPT. COPY: WHITE OWNER COPY (FINAL): YELLOW OWNER COPY (INITIAL): PINK