IREDELL COUNTY HEALTH DEPARTMENT

STATESVILLE 704-878-5305 MOORESVILLE 704-664-5281

IMPROVEMENT PERMIT / AUTHORIZATION TO CONSTRUCT / OPERATION PERMIT / EXISTING SYSTEM INSPECTION

PERMIT# 090660 PIN# 4740 20 3493 4740 20 9149 DATE 7/28/00

OWNER OR CONTRACTOR A.H. Inc PHONE: Business (704) 636-7765 Home

ADDRESS 2310 S. Main St. Salisbury NC 28147

LOCATION Perth Rd, L Clontz Hill, R Ridge Crk, R Wiltshire, L Panther crk, 2nd on Left

SUBDIVISION Wiltshire Crk BLOCK / SECTION LOT 5 LOT AREA .53 SITE CLASS. PS DESIGN FLOW 360 L.T.A.R. 0.5

Septic Tank: 1000 Gallons; STB 825 Date 9/1/00
Pump Tank: Gallons; PT Date
Pump Make: Model Serial No.
Nitrification Field: No Fields 1 Square Feet 1200 Linear Feet 400
No Lines 4@100' Trench Width 36" Max Trench Bottom Depth 36" Gravel Depth 12"

☒ New System ☐ Repair System Type: I, (II), III, IV, V, VI
System Description: Grav. Conv.
Repair System Description: Grav. Conv
Maintenance Agreement Required: ☐ Yes ☒ No


☒ House/Mod. Home No. Bedrooms 3
☐ Mobile Home No. Bathrooms 2
☐ Business No. Employees
☐ Other
☒ Slab ☐ Crawl Space ☐ Basement w/plumbing ☐ Basement wo/plumbing

Water Supply: ☒ Individual ☐ Public ☐ Community


Comments/Conditions: Keep well a minimum of 50' from septic System

Comments/Conditions:

INITIAL SITE SKETCH

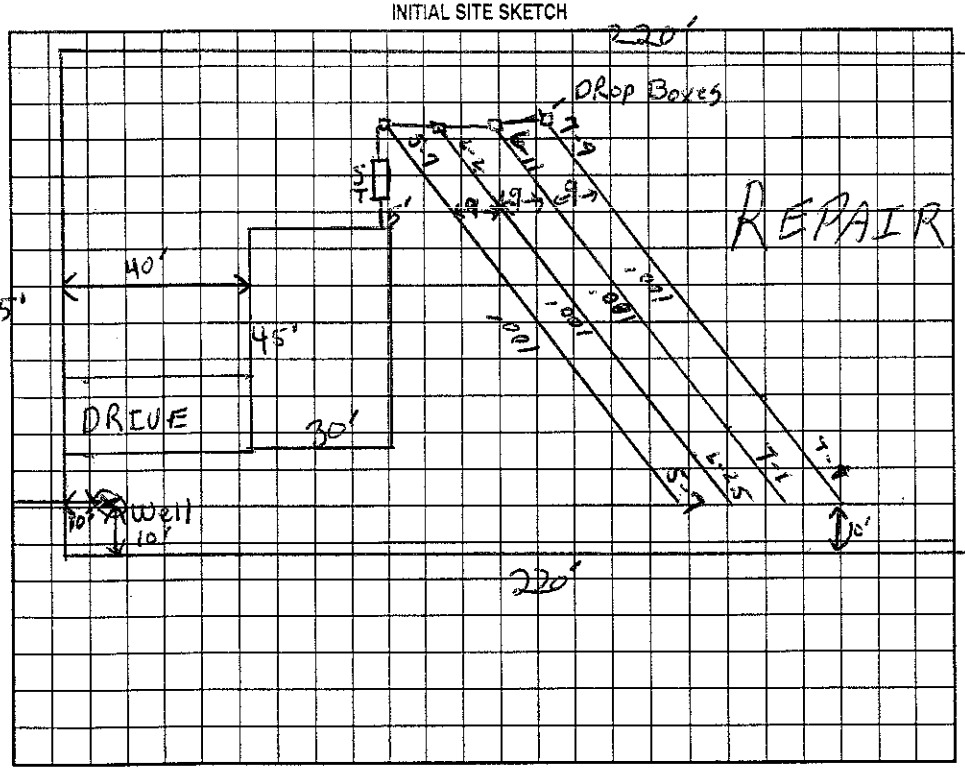

AS BUILT SKETCH

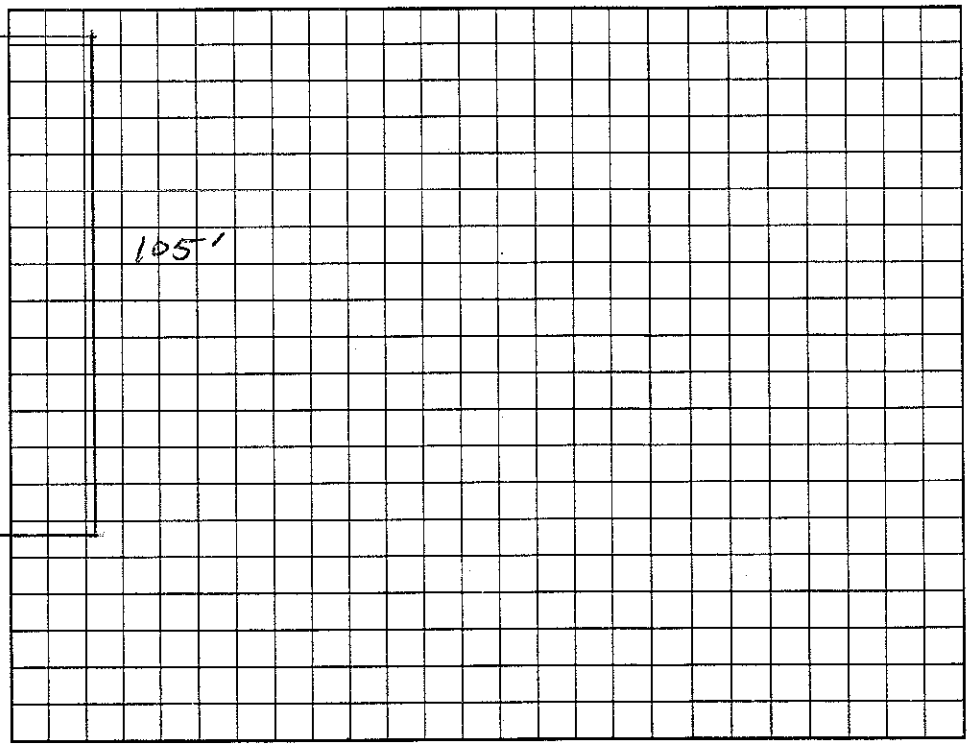

Permit can be suspended or revoked if any false information is supplied toward securing the permit/any unauthorized changes are made to the site/any unauthorized changes are made in the installation of the system. Improvement Permit with plat valid without expiration. Improvement Permit with site plan valid for sixty months. Authorization to Construct is valid for a period equal to that of Improvement Permit – not to exceed sixty months.

Signed: date 8/10/00 Installed by: Rowan Septic Tank

Improvement Permit by: Gary McNeely RSI date 7/28/00 Operation Permit by: Wesley Sparks RS. date 10/2/00

Authorization to Construct by: Gary McNeely RSI date 7/28/00 Existing System Inspection by: date

HEALTH DEPT. COPY: WHITE OWNER COPY (FINAL): YELLOW OWNER COPY (INITIAL): PINK