IREDELL COUNTY HEALTH DEPARTMENT

...LSVILLE 704-878-5305 / 125.00 Paid MOORESVILLE 704-664-5281 3.00

IMPROVEMENT PERMIT / AUTHORIZATION TO CONSTRUCT / OPERATION PERMIT / EXISTING SYSTEM INSPECTION

PERMIT# 093599 PIN# 4740210534 DATE 12/12/2000

OWNER OR CONTRACTOR Spear Construction PHONE: Business M. 202-4964 Home 636-7954

ADDRESS 607 Anderson Ave Salisbury, NC 28144

LOCATION Hwy 15/21 North TL Flower House TL Clontz Hill TL Ridge Creek Dr.

SUBDIVISION Rocky Creek BLOCK / SECTION ____ LOT 19 LOT AREA .53 Acre SITE CLASS. PS DESIGN FLOW 360 L.T.A.R. .35

Septic Tank: 1000 Gallons; STB 825 Date 9/00
Pump Tank: ____ Gallons; PT ____ Date ____
Pump Make: ____ Model ____ Serial No. ____
Nitrification Field: No. Fields 1 Square Feet 765 Linear Feet 255'
No Lines 4 Trench Width 36" Max Trench Bottom Depth 36" Gravel Depth N/A

☒ New System ☐ Repair System Type: I, II, III, IV, V, VI
System Description: Gravity - 25% Reduction
Repair System Description Gravity - Innovative
Maintenance Agreement Required: ☒ Yes ☐ No


☒ House/Mod. Home No. Bedrooms 3
☐ Mobile Home No. Bathrooms 2
☐ Business No. Employees ____
☐ Other ____
☐ Slab ☐ Crawl Space ☐ Basement w/plumbing ☐ Basement wo/plumbing

Water Supply:
☒ Individual
☐ Public
☐ Community

Comments:/Conditions: Keep Septic System at least 10' From PL, 5' from House & 50-100' Feet From any well

Comments:/Conditions: 25% Reduction in Drainfield area.

Scale 1:50 INITIAL SITE SKETCH

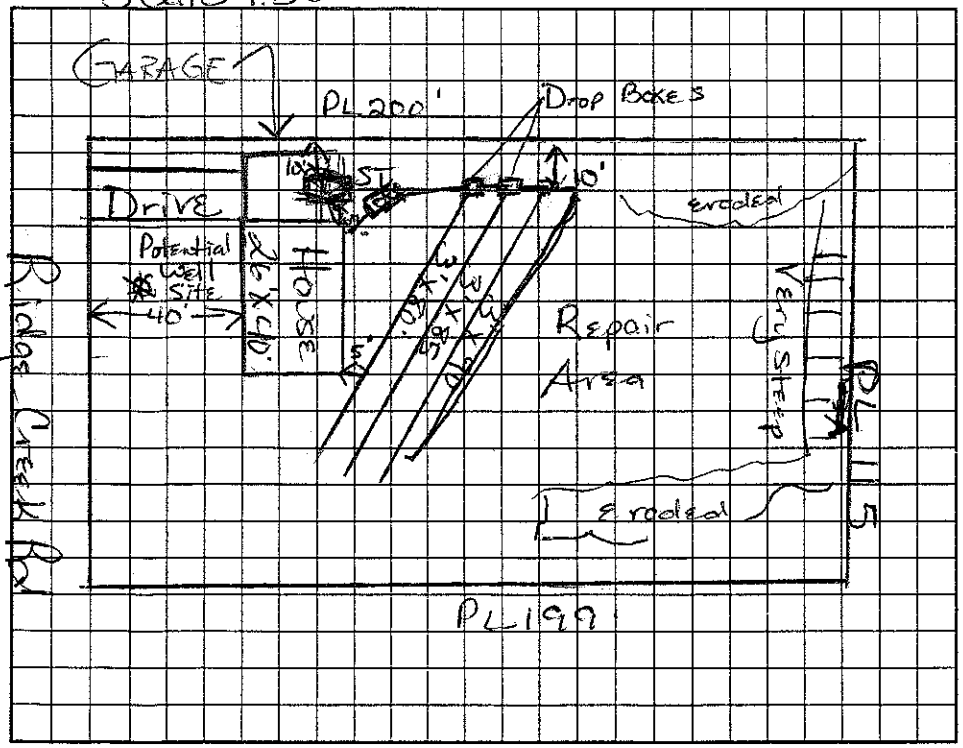

AS BUILT SKETCH

The location of the proposed GARAGE addition does not appear to impact the existing septic system.
**NOTE: R. A. Tolley REHS
Date: 12-22-11
ICHD-Environmental Health Division

Permit can be suspended or revoked if any false information is supplied toward securing the permit/any unauthorized changes are made to the site/any unauthorized changes are made in the installation of the system. Improvement Permit with plat valid without expiration. Improvement Permit with site plan valid for sixty months. Authorization to Construct is valid for a period equal to that of Improvement Permit – not to exceed sixty months.

Signed: ____ date 12/13/00 Installed by: Kowan Septic Tank

Improvement Permit by: Maint H.H. Dotson RS. date 12/12/2000 Operation Permit by: Wesley Sparkes. date 2/19/01

Authorization to Construct by: Maint H.H. Dotson RS date 12/12/2000 Existing System Inspection by: ____ date ____

HEALTH DEPT. COPY: WHITE OWNER COPY (FINAL): YELLOW OWNER COPY (INITIAL): PINK