10:30-11:20

# IREDELL COUNTY HEALTH DEPARTMENT

STATESVILLE 704-878-5305 MOORESVILLE 704-664-5281

## IMPROVEMENT PERMIT / AUTHORIZATION TO CONSTRUCT / OPERATION PERMIT / EXISTING SYSTEM INSPECTION

PERMIT# 086532 PIN# 4740214274 DATE 12/16/99

OWNER OR CONTRACTOR AH Inc. PHONE: Business (704) 528-5484 Home

ADDRESS 450 Aution Dr. Salisbury, NC 28146

LOCATION Perth Rd TL Clontz Hill, TR Ridge Creek at intersection with Wiltshire

SUBDIVISION Rocky Creek Cove BLOCK / SECTION LOT 38 LOT AREA .53 Acre SITE CLASS. PS DESIGN FLOW 360gpd L.T.A.R. .3+

Septic Tank: 1000 Gallons; STB 1512 Date 10/29/99

Pump Tank: Gallons; PT Date

Pump Make: Model Serial No.

Nitrification Field: No Fields 1 Square Feet 1200' Linear Feet 400'

No Lines 5 at 80' Trench Width 36" Max Trench Bottom Depth 18"-36" Gravel Depth 12"

☒ New System ☐ Repair System Type: ☐ I, II, III, IV, V, VI

System Description: Gravity - Conventional

Repair System Description: Gravity - Modified

Maintenance Agreement Required: ☐ Yes ☒ No

☐ House/Mod. Home ☒ Mobile Home ☐ Business ☐ Other

No. Bedrooms 3 No. Bathrooms 2 No. Employees


☐ Slab ☒ Crawl Space ☐ Basement w/plumbing ☐ Basement wo/plumbing

Water Supply: ☒ Individual ☐ Public ☐ Community

Comments:/Conditions: Keep Septic System 10' from PL, 5' from house & 100' from well.

Comments:/Conditions: Note to installer: May be able to install in 4-100' lines but must stay 15' from Road Cut & 10' From PL

INITIAL SITE SKETCH Scale 1:50'

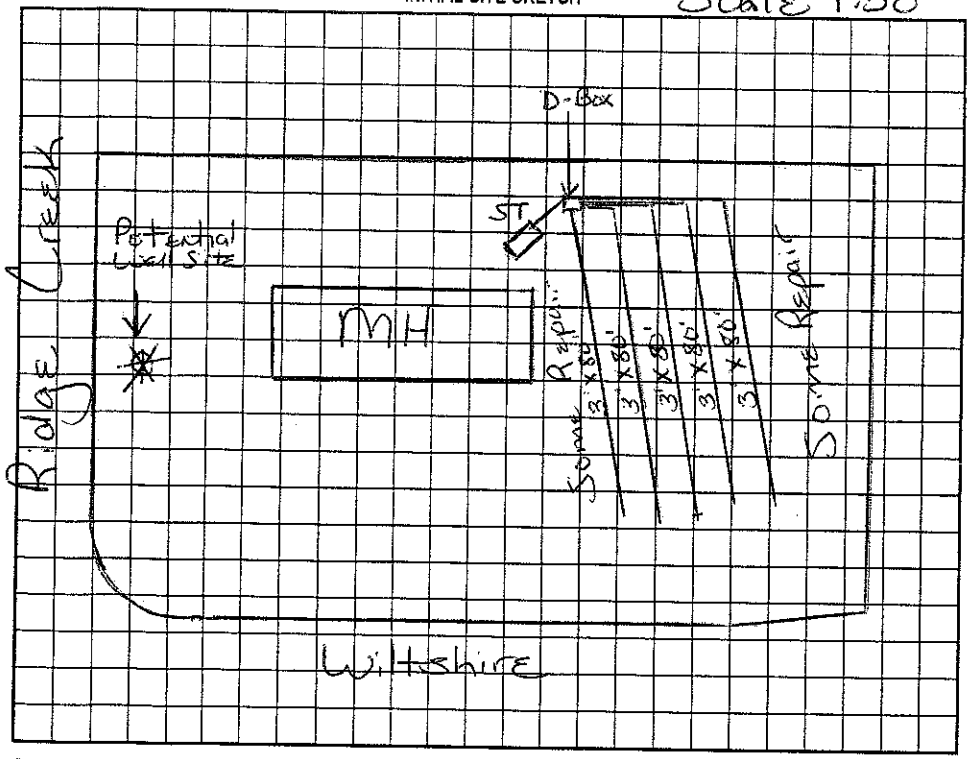


AS BUILT SKETCH

Permit can be suspended or revoked if any false information is supplied toward securing the permit/any unauthorized changes are made to the site/any unauthorized changes are made in the installation of the system. Improvement Permit with plat valid without expiration. Improvement Permit with site plan valid for sixty months. Authorization to Construct is valid for a period equal to that of Improvement Permit – not to exceed sixty months.

Signed: Dennis Dallas date 12-17-99 Installed by: A-1 Backhoe

Improvement Permit by: Maria H.H. Dolan RS. date 12/16/99 Operation Permit by: Wesley Sparks RS. date 12/29/99

Authorization to Construct by: Maria H.H. Dolan RS. date 12/16/99 Existing System Inspection by: date

HEALTH DEPT. COPY: WHITE OWNER COPY (FINAL): YELLOW OWNER COPY (INITIAL): PINK