IREDELL COUNTY HEALTH DEPARTMENT

STATESVILLE 704-878-5305 130.00 Paid MOORESVILLE 704-664-5281

Owes $130.00

IMPROVEMENT PERMIT / AUTHORIZATION TO CONSTRUCT / OPERATION PERMIT / EXISTING SYSTEM INSPECTION

PERMIT# 105469 PIN# 4740-21-8425 DATE 4/30/02

OWNER OR CONTRACTOR Rocky River LLC PHONE: Business 704-202-5234 Home

ADDRESS 456 Action Dr. Salisbury, NC. 28147

LOCATION Penth Rd. N TR Crosty Hill Rd. TR Rocky Creek Dr. to lot on (L)

SUBDIVISION Rocky Creek BLOCK / SECTION LOT 26 LOT AREA .53Ac SITE CLASS. PS DESIGN FLOW 360 L.T.A.R. .3

Septic Tank: 1000 Gallons; STB 994 Date 2/28/02

Pump Tank: Gallons; PT Date

Pump Make: Model Serial No.

Nitrification Field: No Fields 1 Square Feet 900 * Linear Feet 300 *

No Lines 4 @ 75' Trench Width 3 Max Trench Bottom Depth 3 Gravel Depth No

[X] New System [ ] Repair System Type: I, II, (III), IV, V, VI

System Description: GR. - EZ LAY/CH PLASTIC

Repair System Description: 16" PABAS

Maintenance Agreement Required: [ ] Yes [X] No

[X] House/Mod. Home [ ] Mobile Home [ ] Business [ ] Other

No. Bedrooms 3 No. Bathrooms 2 No. Employees

[ ] Slab [X] Crawl Space [ ] Basement w/plumbing [ ] Basement wo/plumbing


Water Supply: [X] Individual [ ] Public [ ] Community

Comments:/Conditions:

Comments:/Conditions:

(1" = 50')

INITIAL SITE SKETCH

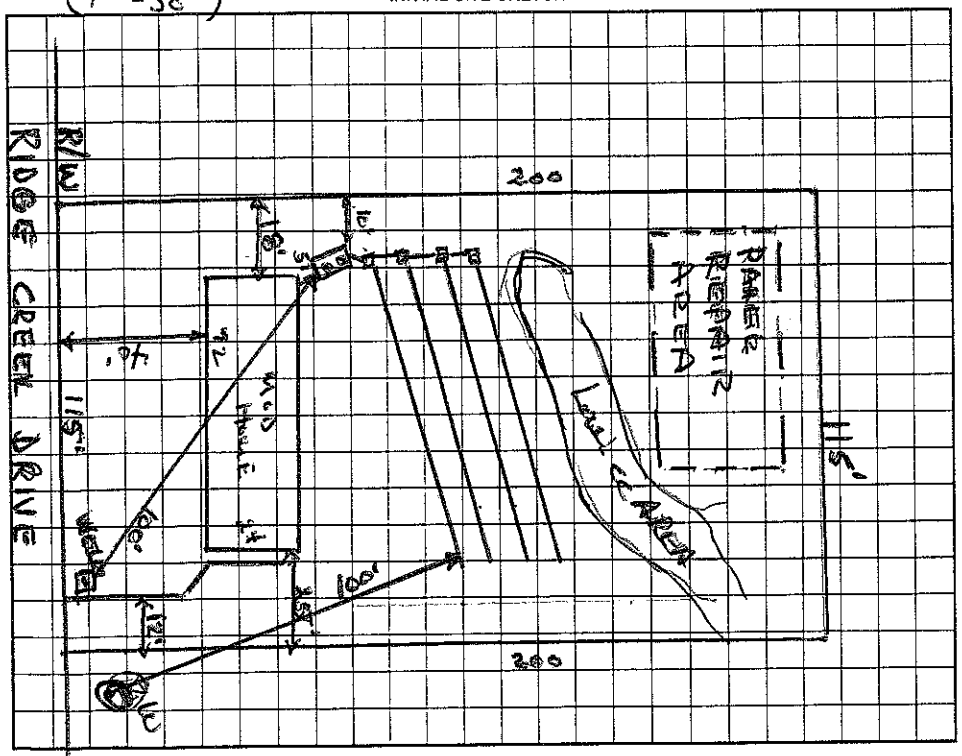

AS BUILT SKETCH

Permit can be suspended or revoked if any false information is supplied toward securing the permit/any unauthorized changes are made to the site/any unauthorized changes are made in the installation of the system. Improvement Permit with plat valid without expiration. Improvement Permit with site plan valid for sixty months. Authorization to Construct is valid for a period equal to that of Improvement Permit – not to exceed sixty months.

Signed: * date

Improvement Permit by: Wesley Sparks RS date 4/30/02

Authorization to Construct by: Wesley Sparks RS. date 4/30/02

Installed by: Kenny Madison

Operation Permit by: Wesley Sparks RS. date 9/9/02

Existing System Inspection by: date

HEALTH DEPT. COPY: WHITE OWNER COPY (FINAL): YELLOW OWNER COPY (INITIAL): PINK