IREDELL COUNTY HEALTH DEPARTMENT

STATESVILLE 704-878-5305 Paid 125.00 MOORESVILLE 704-664-5281 3!

IMPROVEMENT PERMIT / AUTHORIZATION TO CONSTRUCT / OPERATION PERMIT / EXISTING SYSTEM INSPEC

PERMIT# 088370 PIN# 4740219433 DATE 10-6

OWNER OR CONTRACTOR A H Inc PHONE: Business 202-5234 (Allen) Home

ADDRESS 450 Auction Rd. Salisbury, NC 27145

LOCATION Flower House Loop TL Clontz Hill TL Ridge Creek on left

SUBDIVISION Rocky Creek Cove BLOCK / SECTION LOT 27 LOT AREA .53 Acre SITE CLASS PS DESIGN FLOW 360gpd L.T.A.R. .3+

Septic Tank: 1000 Gallons; STB 620 Date 8-13-00
Pump Tank: Gallons; PT Date
Pump Make: Model Serial No.
Nitrification Field: No Fields 1 Square Feet 1200' Linear Feet 300'
No Lines 4 at 75' Trench Width 36" Max Trench Bottom Depth 36"

[X] New System [ ] Repair System Type: I, II, III, IV, V, VI
System Description: Gravity - 25% Reduction
Repair System Description: Gravity - Innovative
Maintenance Agreement Required: [ ] Yes [X] No


[X] House/Mod. Home No. Bedrooms 3
[X] Mobile Home No. Bathrooms 2
[ ] Business No. Employees
[ ] Other
Gravel Depth N/A [ ] Slab [X] Crawl Space [ ] Basement w/plumbing [ ] Basement wo/plumbing

Water Supply: [X] Individual [ ] Public [ ] Community

Comments:/Conditions: Keep Septic System at least 10' from PL, 5' from House & 50'+ any well.

Comments:/Conditions: Filter installed
* Well not installed at time of inspection.

INITIAL SITE SKETCH Scale 1:50'

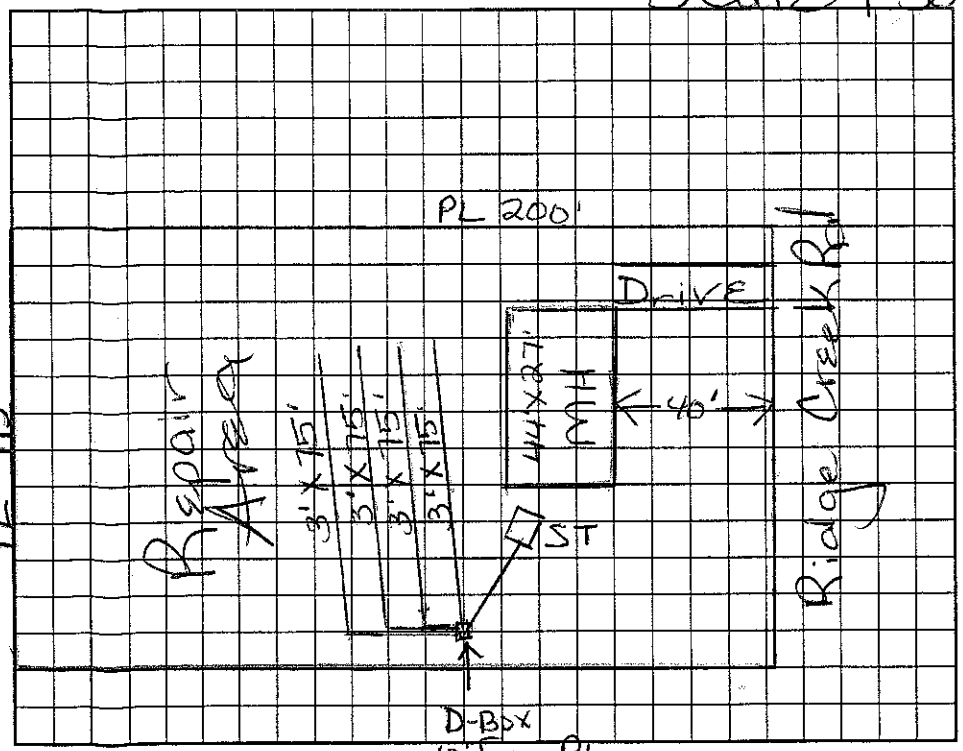

AS BUILT SKETCH

Installed as Drawn

Permit can be suspended or revoked if any false information is supplied toward securing the permit/any unauthorized changes are made to the site/any unauthorized changes are made in the installation of the system. Improvement Permit with plat valid without expiration. Improvement Permit with site plan valid for sixty months. Authorization to Construct is valid for a period equal to that of Improvement Permit – not to exceed sixty months.

Signed: X [signature] date 10-9-00 Installed by: Madison Brothers

Improvement Permit by: Maria H. Dotson RS date 10/6/2000 Operation Permit by: Maria H. Dotson RS date 10/20/2000

Authorization to Construct by: Maria H. Dotson RS date 10/9/2000 Existing System Inspection by: date

HEALTH DEPT. COPY: WHITE OWNER COPY (FINAL): YELLOW OWNER COPY (INITIAL): PINK