11:00

IREDELL COUNTY HEALTH DEPARTMENT

STATESVILLE 704-878-5305 MOORESVILLE 704-664-5281

IMPROVEMENT PERMIT / AUTHORIZATION TO CONSTRUCT / OPERATION PERMIT / EXISTING SYSTEM INSPECTION

PERMIT# 111279 PIN# 4740 22 9296 DATE 3/4/03

OWNER OR CONTRACTOR John T Williams PHONE: Business Home 704-528-9656

ADDRESS 277 Clontz Hill Rd. Trentmon, NC.

LOCATION 115 N FH Loop TL Clontz Hill on (L) #277

SUBDIVISION N/A BLOCK / SECTION LOT LOT AREA ~2 AC SITE CLASS. PS DESIGN FLOW 360 L.T.A.R. .3

Septic Tank: 1000 Gallons; STB 1012 Date 5-17-03
Pump Tank: Gallons; PT Date
Pump Make: Model Serial No.
Nitrification Field: No Fields 1 Square Feet 900* Linear Feet 300*
No Lines 3@100' Trench Width 3' Max Trench Bottom Depth 36" Gravel Depth N/A

[X] New System [ ] Repair System Type: I, II, (III), IV, V, VI
System Description: GRAVITY-TYPE 3 MATERIAL
Repair System Description: Pressure to Conventional
Maintenance Agreement Required: [ ] Yes [X] No
[ ] Slab [ ] Crawl Space [X] Basement w/plumbing [ ] Basement wo/plumbing


[X] House/Mod. Home No. Bedrooms 3
[ ] Mobile Home No. Bathrooms 3
[ ] Business No. Employees
[ ] Other

Water Supply: [X] Individual [ ] Public [ ] Community


Comments:/Conditions: Repair area on (R) of main driveway in open field area near garden plot; pressure required for Repair. System not flagged due to clearing left to landowner. LOCATED

Comments:/Conditions: Yellow filter installed

INITIAL SITE SKETCH

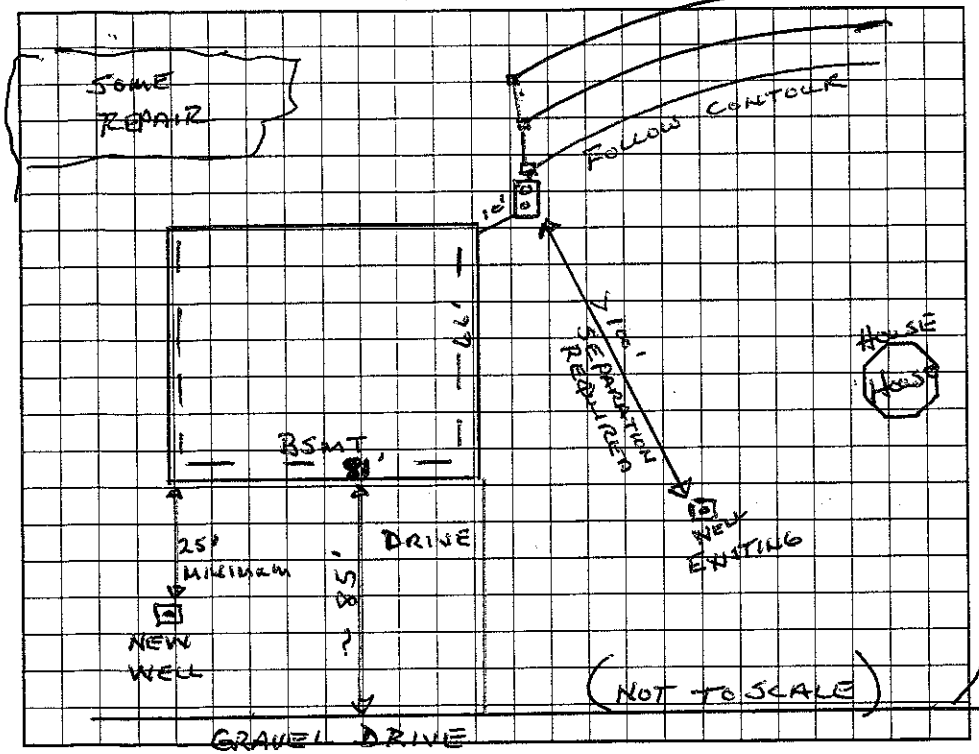

AS BUILT SKETCH

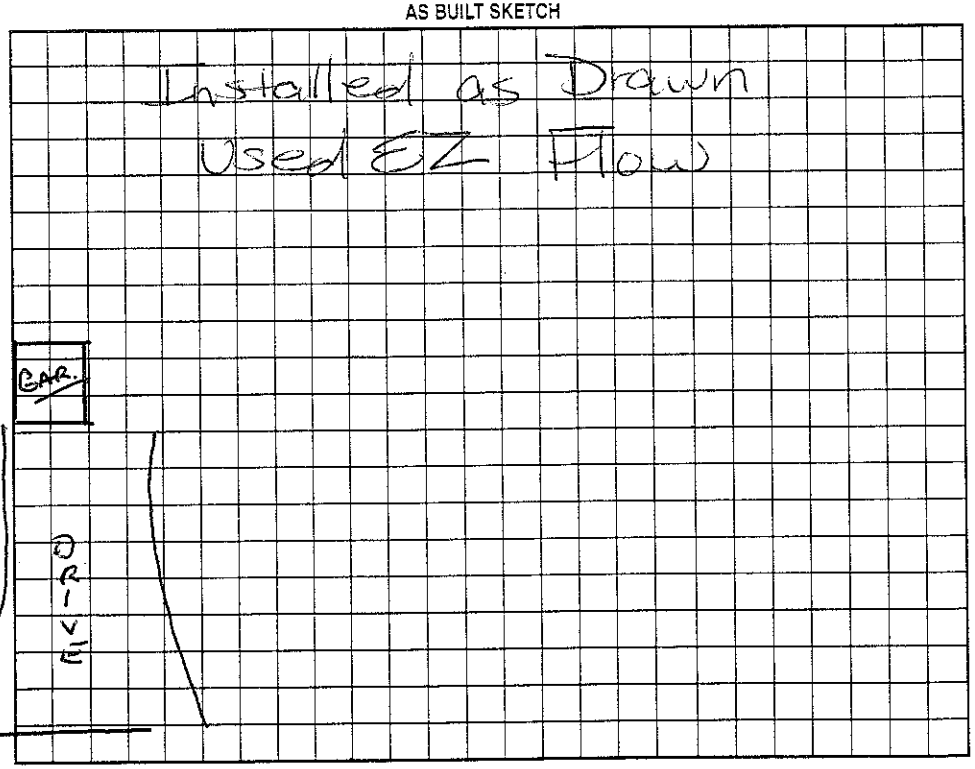

Permit can be suspended or revoked if any false information is supplied toward securing the permit/any unauthorized changes are made to the site/any unauthorized changes are made in the installation of the system. Improvement Permit with plat valid without expiration. Improvement Permit with site plan valid for sixty months. Authorization to Construct is valid for a period equal to that of Improvement Permit – not to exceed sixty months.

Signed: X Randall E. Brown date

Improvement Permit by: Wesley Sparks RS. date 3/4/03

Authorization to Construct by: Wesley Sparks RS. date 3/4/03

Installed by: Tommy Tyre RS.

Operation Permit by: Maiwand Hotaki date 11/14/03

Existing System Inspection by: date

HEALTH DEPT. COPY: WHITE OWNER COPY (FINAL): YELLOW OWNER COPY (INITIAL): PINK