4:15

IREDELL COUNTY HEALTH DEPARTMENT

STATESVILLE 704-878-5305 MOORESVILLE 704-664-5281

IMPROVEMENT PERMIT / CERTIFICATE OF COMPLETION / OPERATION PERMIT / EXISTING SYSTEM INSPECTION

PROPERTY DESCRIPTION NO. 21804 DATE 8-28-95 TAX MAP NO. 34-C-9C Watershed: ☐ Yes ☒ No

OWNER OR CONTRACTOR THERITHA COWAN PHONE: Business 704-873-8283 Home

ADDRESS 1303 WILSONLEE BLVD. STATESVILLE NC. 28677

LOCATION 115 S TR BYERS RD. TO END ON LEFT

SUBDIVISION BLOCK / SECTION LOT LOT AREA 2 ACRE SITE CLASS. PS DESIGN FLOW L.T.A.R. .35

Septic Tank: 1000 Gallons; STB 794 Date 6-2095 ☒ New System ☐ Repair System Type: I, (II), III, IV, V, VI

Pump Tank: Gallons; PT Date System Description: GRAV. CONV.

Pump Make: Model Serial No. Repair System Description: Gravity PPBS

Nitrification Field: No Fields 1 Square Feet 1050 Linear Feet 350 Maintenance Agreement Required: ☐ Yes ☒ No

No Lines 5 Trench Width 3' Max Trench Bottom Depth 36" Gravel Depth 12"

☐ House/Mod. Home ☒ Mobile Home ☐ Business ☐ Other

No. Bedrooms 3 No. Bathrooms 2 No. Employees


☐ Slab ☒ Crawl Space ☐ Basement w/plumbing ☐ Basement wo/plumbing

Water Supply: ☒ Individual ☐ Community ☐ Public

Comments:

Comments:

INITIAL SITE SKETCH

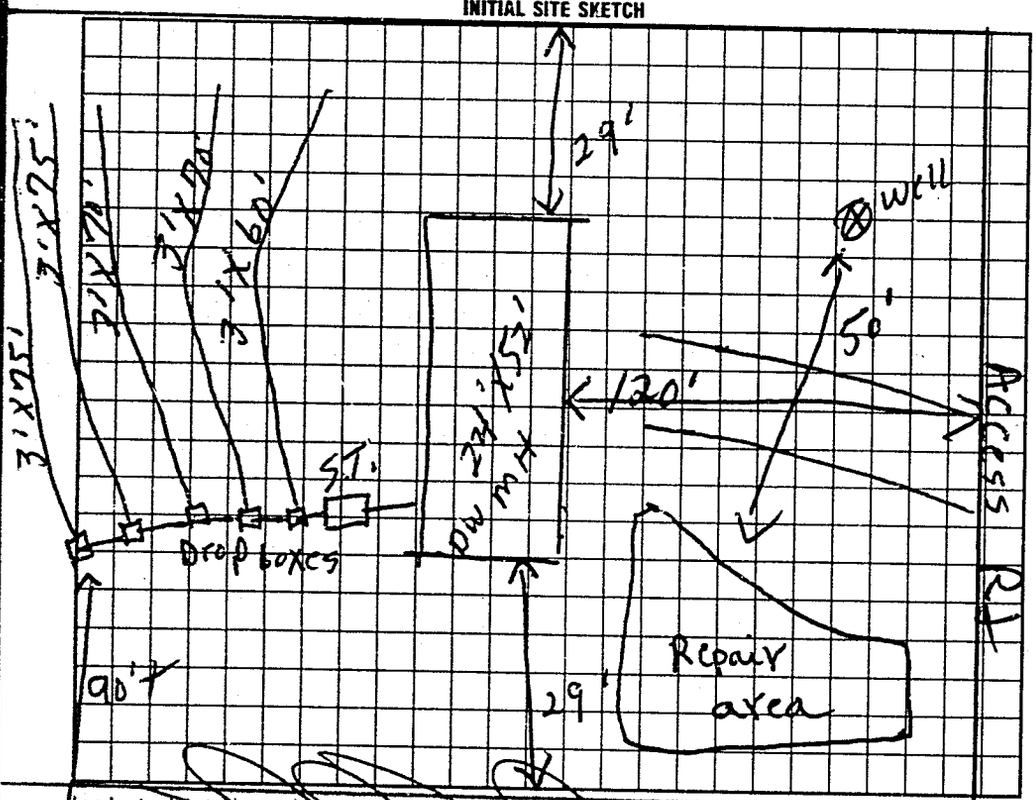

AS BUILT SKETCH

Same as initial sketch

I understand that this permit can be suspended or revoked if any false information is supplied toward securing the permit/any unauthorized changes are made to the site/any unauthorized changes are made in the installation of the system.

Signed: X

Improvement Permit by: L.C. moore date 8-28-95

Existing System Inspection by: date

Installed by: A-1 Backhoe

Certificate of Completion by: L.C. moore date 9-13-95

Operation Permit by date

Well - next door

HEALTH DEPT. COPY WHITE INSPECTION COPY (FINAL) GREEN OWNER COPY (FINAL) YELLOW INSPECTION COPY (INITIAL) PINK OWNER COPY (INITIAL) GOLD