47523

IREDELL COUNTY HEALTH DEPARTMENT

STATESVILLE 704-878-5305 MOORESVILLE 704-664-5281

IMPROVEMENT PERMIT / CERTIFICATE OF COMPLETION / OPERATION PERMIT / EXISTING SYSTEM INSPECTION

PROPERTY DESCRIPTION NO. Town of Troutman DATE 10-12-93 TAX MAP NO. 3HC96

OWNER OR CONTRACTOR Elvert Cowan PHONE: Business _____ Home 873-8283

ADDRESS _____

LOCATION Hwy 215 TR Byres Rd. 2nd Lot on L after road turns into gravel

SUBDIVISION NA BLOCK / SECTION _____ LOT _____ LOT AREA 1.20 acres SITE CLASS. P.S. L.T.A.R. .35gpd/ft²

Water Supply: ☑ Individual ☐ Community ☐ Public

Septic Tank: 1000 Gallons; STB 1012 Date 8-13-93

Pump Tank: — Gallons; PT — Date —

Nitrification Field: No Fields 1 Square Feet 1035 Linear Feet 345'

No Lines 4 Trench Width 36" Trench Depth 18"-36" Gravel Depth 12"

☑ New System ☐ Repair System Type: I. II. V. VI

System Description: Conventional, gravity

Repair System Description: "

Maintenance Agreement Required: ☐ Yes ☑ No

☑ House/Mod. Home ☐ Mobile Home ☐ Business ☐ Other

No. Bedrooms 3 No. Bathrooms 2 No. Employees —

☐ Slab ☑ Crawl Space ☐ Basement w/plumbing ☐ Basement wo/plumbing

Garbage Disposal: ☐ Yes ☑ No


Auto. Dishwasher: ☐ Yes ☑ No

Auto. Washing Machine: ☑ Yes ☐ No


Other _____

Comments 100% Repair Area behind house, conventional, gravity fed. Well not located at time of inspection. Keep well min. 50' from septic system and 100% Repair Area

INITIAL SITE SKETCH

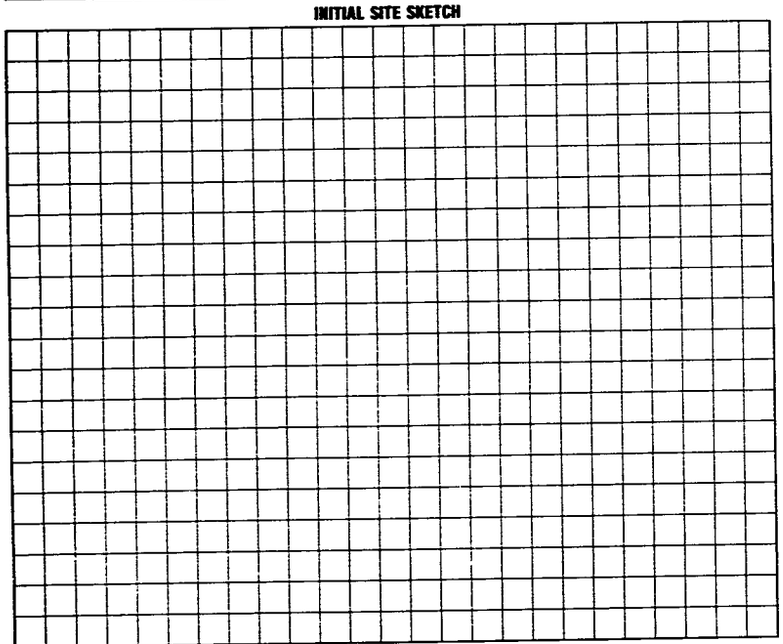

AS BUILT SKETCH

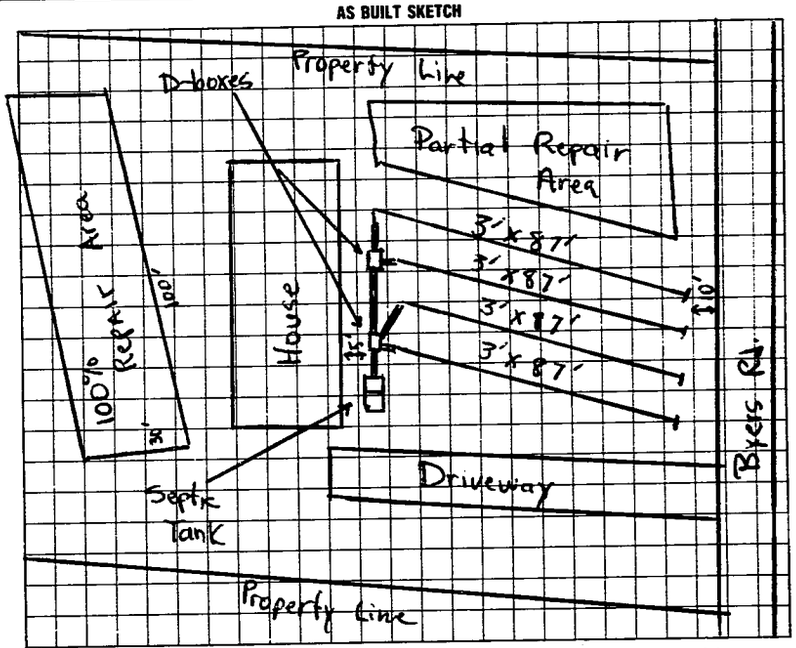

I understand that this permit can be suspended or revoked if any false information is supplied toward securing the permit/any unauthorized changes are made to the site/any unauthorized changes are made in the installation of the system. Improvement Permit is valid for 60 months from date of issuance.

Signed: _____

Improvement Permit by: Michael J. Dennis date 5-19-93

Existing System Inspection by: _____ date _____

Installed by: Forest Shuford

Certificate of Completion by: Michael J. Dennis date 10-12-93

Operation Permit by: _____ date _____

HEALTH DEPT. COPY: WHITE INSPECTION COPY (FINAL): GREEN OWNER COPY (FINAL): YELLOW INSPECTION COPY (INITIAL): PINK OWNER COPY (INITIAL): GOLD