2 of

IREDELL COUNTY HEALTH DEPARTMENT

STATESVILLE 704-878-5305 MOORESVILLE 704-664-5281

IMPROVEMENT PERMIT / AUTHORIZATION TO CONSTRUCT / OPERATION PERMIT / EXISTING SYSTEM INSPECTION

PERMIT# 91125 PIN# ~~4740203493~~ 4740301158 DATE 9/4/01

OWNER OR CONTRACTOR AH Inc / Spear Const. PHONE: Business 704-636-7765 Home

ADDRESS 2310 S. Main St Salisbury NC 28147

LOCATION Perth, TR Clontz Hill, TR Ridge Crk TR Withrow, TL Panther Crk on Corner of Coquina

SUBDIVISION Withrow Crk BLOCK / SECTION LOT 7 LOT AREA 0.55AC SITE CLASS. PS DESIGN FLOW 360 L.T.A.R. 0.3

Septic Tank: 1000 Gallons; STB 825 Date 11/5/01

Pump Tank: Gallons; PT Date

Pump Make: Model Serial No.

Nitrification Field: No Fields 1 Square Feet 900 Linear Feet 300

No Lines 5@60' Trench Width 36" Max Trench Bottom Depth 36" Gravel Depth —

☒ New System ☐ Repair System Type: I, II, (III), IV, V, VI

System Description: Gravity 25% Red.

Repair System Description: / Same

Maintenance Agreement Required: ☐ Yes ☒ No

☒ House/Mod. Home No. Bedrooms 3

☐ Mobile Home No. Bathrooms 2

☐ Business No. Employees

☐ Other

☐ Slab ☒ Crawl Space ☐ Basement w/plumbing ☐ Basement wo/plumbing

Water Supply: ☒ Individual ☐ Public ☐ Community


Comments:/Conditions:

House plans reviewed 9/7/01 House size 48'X32'

Comments:/Conditions:

Infiltrator installed.

1"=50' INITIAL SITE SKETCH

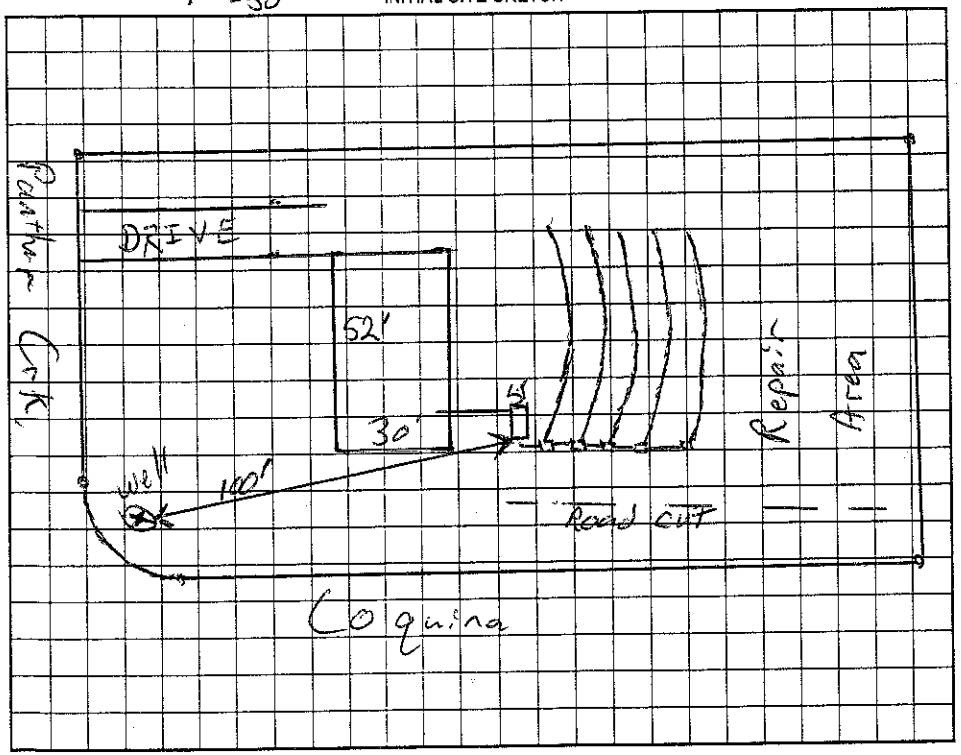

AS BUILT SKETCH

Permit can be suspended or revoked if any false information is supplied toward securing the permit/any unauthorized changes are made to the site/any unauthorized changes are made in the installation of the system. Improvement Permit with plat valid without expiration. Improvement Permit with site plan valid for sixty months. Authorization to Construct is valid for a period equal to that of Improvement Permit -- not to exceed sixty months.

Signed: date

Improvement Permit by: RST date 9/4/01

Authorization to Construct by: RST date 9/7/01

Installed by: Rowan Septic Tank

Operation Permit by: Wesley Sparks R.S. date 1/10/02

Existing System Inspection by: date

HEALTH DEPT. COPY: WHITE OWNER COPY (FINAL): YELLOW OWNER COPY (INITIAL): PINK