IREDELL COUNTY HEALTH DEPARTMENT

STATESVILLE 704-878-5305 MOORESVILLE 704-664-5281

IMPROVEMENT PERMIT / AUTHORIZATION TO CONSTRUCT / OPERATION PERMIT / EXISTING SYSTEM INSPECTION

PERMIT# 09134 9 PIN# 4740203493 4740 30 7160 DATE 9/10/01

OWNER OR CONTRACTOR AH Inc / Max Spear Const. PHONE: Business 704 202 4964 Home

ADDRESS 607 Anderson Ave. Salisbury NC 28144

LOCATION Perth, TR Cloaty Hill, TR Ridge Creek, TR Wiltshire, TL E Panther Crk on Corner of Carrissa Ln.

SUBDIVISION Wiltshire Crk BLOCK / SECTION LOT 41 LOT AREA 0.63 Ac SITE CLASS. PS DESIGN FLOW 360 L.T.A.R. 0.3

Septic Tank: 1000 Gallons; STB 825 Date 8/21/01

Pump Tank: Gallons; PT Date

Pump Make: Model Serial No.

Nitrification Field: No Fields 1 Square Feet 900 Linear Feet 300

No Lines 4 Trench Width 36" Max Trench Bottom Depth 36"

☒ New System ☐ Repair System Type: I, II, (III), IV, V, VI

System Description: Gravity 25% Reduction

Repair System Description: LP Panel

Maintenance Agreement Required: ☐ Yes ☒ No

Gravel Depth —

☒ House/Mod. Home No. Bedrooms 3

☐ Mobile Home No. Bathrooms 2

☐ Business No. Employees

☐ Other


☐ Slab ☒ Crawl Space ☐ Basement w/plumbing ☐ Basement wo/plumbing

Water Supply: ☒ Individual ☐ Public ☐ Community


Comments:/Conditions: Install lines on Contour - Keep Well 100' from septic - Do not cut house site.

Comments:/Conditions:

INITIAL SITE SKETCH 1" = 40' 234.35

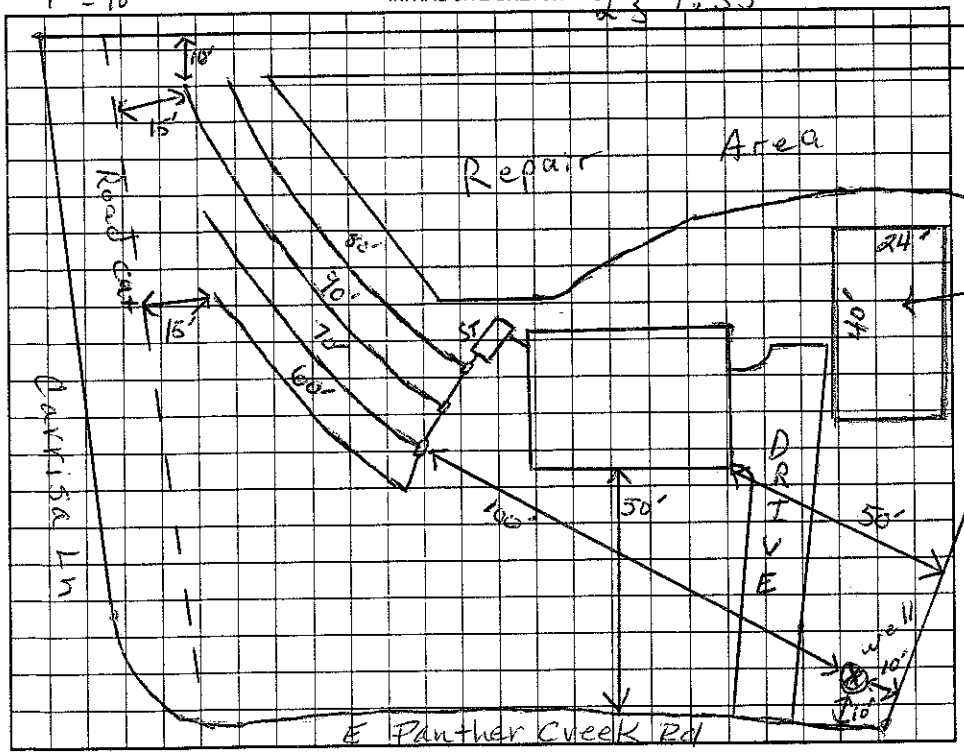

AS BUILT SKETCH

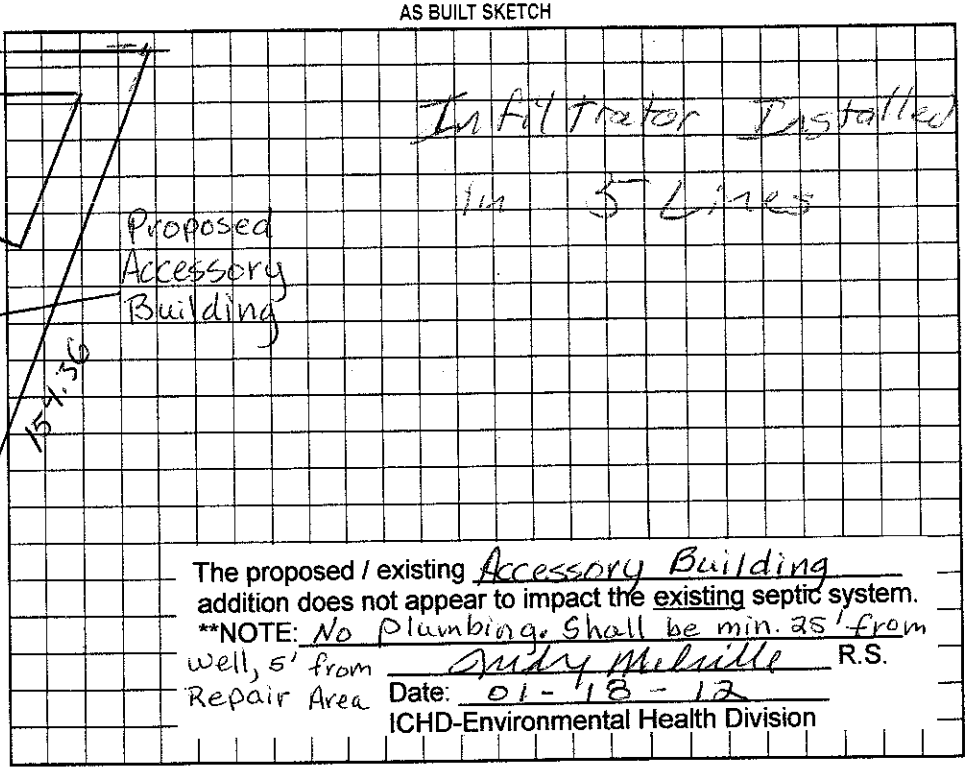

The proposed / existing Accessory Building addition does not appear to impact the existing septic system.

**NOTE: No Plumbing. Shall be min. 25' from well, 5' from Repair Area

Judy Melville R.S.

Date: 01-18-12

ICHD-Environmental Health Division

Permit can be suspended or revoked if any false information is supplied toward securing the permit/any unauthorized changes are made to the site/any unauthorized changes are made in the installation of the system. Improvement Permit with plat valid without expiration. Improvement Permit with site plan valid for sixty months. Authorization to Construct is valid for a period equal to that of Improvement Permit – not to exceed sixty months.

Signed: date 9/12/01

Improvement Permit by: RSI date 9/10/01

Authorization to Construct by: RSI date 9/10/01

Installed by: Rowan Septic

Operation Permit by: RSI date 10/25/01

Existing System Inspection by: date

HEALTH DEPT. COPY: WHITE OWNER COPY (FINAL): YELLOW OWNER COPY (INITIAL): PINK