IREDELL COUNTY HEALTH DEPARTMENT

STATESVILLE 704-878-5305 155.00 Paid MOORESVILLE 704-664-5281

IMPROVEMENT PERMIT / AUTHORIZATION TO CONSTRUCT / OPERATION PERMIT / EXISTING SYSTEM INSPECTION

PERMIT# 091348 PIN# ~~4740 20 3493 pt~~ 4740308063 DATE Aug 5, 02

OWNER OR CONTRACTOR AH Inc & Pilot Builders LLC PHONE: Business 202-4964 Home

ADDRESS 450 Auction Dr. Salisbury

LOCATION Perth RR N TR Cloate Hill TR Ridge Creek TR Wiltshire TR Panther Creek TR ~~Sutherland~~ CARISSA on right

SUBDIVISION Wiltshire Creek BLOCK / SECTION LOT 40 LOT AREA .63 Ac SITE CLASS. PS DESIGN FLOW 360gpd L.T.A.R. .03

Septic Tank: 1000 Gallons; STB 825 Date 10/2/02
Pump Tank: 1000 Gallons; PT 362 Date 6.5.02
Pump Make: ZOELLER Model N-98 Serial No.
Nitrification Field: No Fields 1 Square Feet 900 Linear Feet 300
No Lines 3@100' Trench Width 36" Max Trench Bottom Depth 36" Gravel Depth NA

☑ New System ☐ Repair System Type: I, II, III, IV, V, VI
System Description: PM- 25% Reduction
Repair System Description: CP 25% Reduction
Maintenance Agreement Required: ☐ Yes ☑ No

☑ House/Mod. Home No. Bedrooms 3
☐ Mobile Home No. Bathrooms 2
☐ Business No. Employees
☐ Other
☐ Slab ☑ Crawl Space ☐ Basement w/plumbing ☐ Basement wo/plumbing


Water Supply: ☑ Individual ☐ Public ☐ Community

Comments:/Conditions:

Comments:/Conditions: INFILTRATOR INSTALLED

1"=50'

INITIAL SITE SKETCH

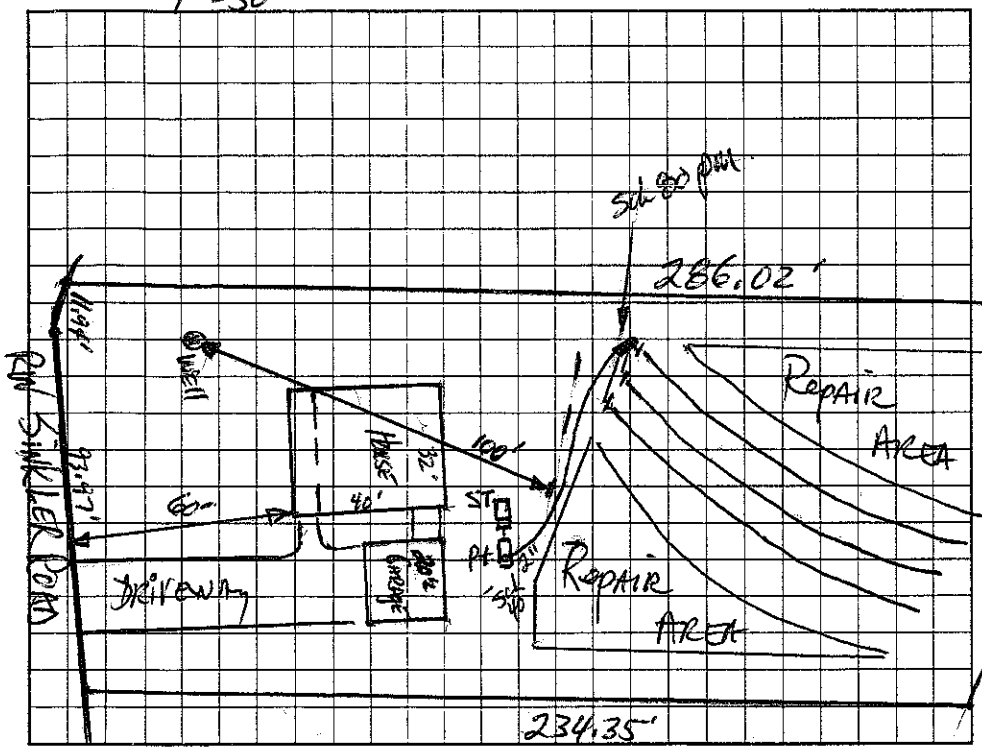

AS BUILT SKETCH

Permit can be suspended or revoked if any false information is supplied toward securing the permit/any unauthorized changes are made to the site/any unauthorized changes are made in the installation of the system. Improvement Permit with plat valid without expiration. Improvement Permit with site plan valid for sixty months. Authorization to Construct is valid for a period equal to that of Improvement Permit – not to exceed sixty months.

Signed: date 8/19/02 Installed by: Rowan Septic Tank

Improvement Permit by: date 8-5-02 Operation Permit by: RS date 12/02/02

Authorization to Construct by: date 8-5-02 Existing System Inspection by: date

HEALTH DEPT. COPY: WHITE OWNER COPY (FINAL): YELLOW OWNER COPY (INITIAL): PINK