IREDELL COUNTY HEALTH DEPARTMENT

STATESVILLE 704-878-5305 MOORESVILLE 704-664-5281

IMPROVEMENT PERMIT / AUTHORIZATION TO CONSTRUCT / OPERATION PERMIT / EXISTING SYSTEM INSPECTION

PERMIT# 080102 PIN# 4740311450 DATE 3/25/99

OWNER OR CONTRACTOR AH Inc. PHONE: Business 704-855-1999 Home

ADDRESS 420 Auction Dr. Salisbury NC 28144

LOCATION Perth, TL Clontz Hill, TR Ridge Creek, on LT

SUBDIVISION Rocky Creek BLOCK / SECTION LOT 29 LOT AREA .53 SITE CLASS. PS DESIGN FLOW 360 L.T.A.R. .3

Septic Tank: 1000 Gallons; STB 825 Date 3/17/99
Pump Tank: Gallons; PT Date
Pump Make: Model Serial No.
Nitrification Field: No Fields 1 Square Feet 1200 Linear Feet 400
No Lines 5 @ 80 Trench Width 36" Max Trench Bottom Depth 36" Gravel Depth 12"

☒ New System ☐ Repair System Type: I (II) III, IV, V, VI
System Description: Gravity/Conv.
Repair System Description: Chamber/Panel
Maintenance Agreement Required: ☐ Yes ☐ No


☒ House/Mod. Home No. Bedrooms 3
☐ Mobile Home No. Bathrooms 2
☐ Business No. Employees
☐ Other
☐ Slab ☒ Crawl Space ☐ Basement w/plumbing ☐ Basement wo/plumbing

Water Supply: ☒ Individual ☐ Public ☐ Community

Comments:/Conditions: Install lines on contour
Keep septic 10' off PL & 5' off House
Well Min 50' from Septic

Comments:/Conditions: installed as drawn.

INITIAL SITE SKETCH

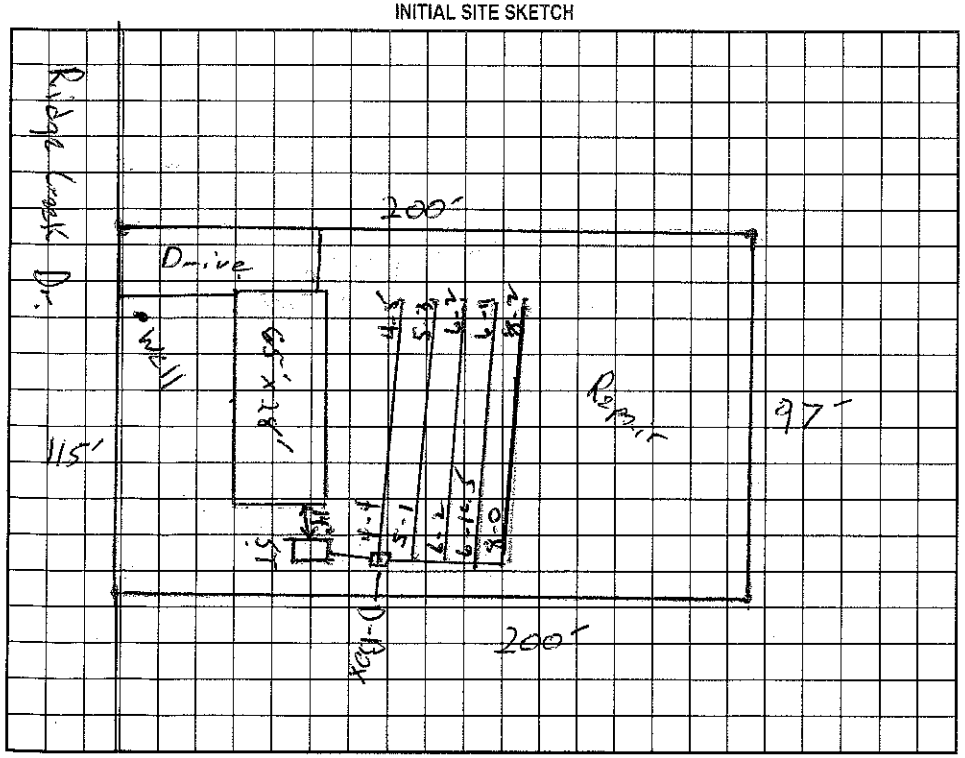

AS BUILT SKETCH

Permit can be suspended or revoked if any false information is supplied toward securing the permit/any unauthorized changes are made to the site/any unauthorized changes are made in the installation of the system. Improvement Permit with plat valid without expiration. Improvement Permit with site plan valid for sixty months. Authorization to Construct is valid for a period equal to that of Improvement Permit – not to exceed sixty months.

Signed: date 3/31/99 Installed by: Rowan Septic Tank

Improvement Permit by: Jeff Morgan date 3/25/99 Operation Permit by: Wesley Sparks RS date 5/6/99

Authorization to Construct by: Jeff Morgan date 3/25/99 Existing System Inspection by: date

HEALTH DEPT. COPY: WHITE OWNER COPY (FINAL): YELLOW OWNER COPY (INITIAL): PINK