4:00

IREDELL COUNTY HEALTH DEPARTMENT

STATESVILLE 704-878-5305 MOORESVILLE 704-664-5281

IMPROVEMENT PERMIT / AUTHORIZATION TO CONSTRUCT / OPERATION PERMIT / EXISTING SYSTEM INSPECTION

PERMIT# 079497 PIN# 4740312145 DATE 3/24/99

OWNER OR CONTRACTOR AH INC PHONE: Business 704-855-2300 Home

ADDRESS 204 Auction Dr. Salisbury NC 28203

LOCATION Flower House, TR Clontz Hill, TL Rocky Creek, At end

SUBDIVISION Rocky Creek BLOCK / SECTION LOT 32 LOT AREA 1.39 SITE CLASS. PS DESIGN FLOW 360 L.T.A.R. .3

Septic Tank: 1000 Gallons; STB 625 Date 4/1/97
Pump Tank: Gallons; PT Date
Pump Make: Model Serial No.
Nitrification Field: No Fields 1 Square Feet 1200 Linear Feet 400
No Lines 4@100 Trench Width 36" Max Trench Bottom Depth 36" Gravel Depth 12"

☒ New System ☐ Repair System Type: I, II, III, IV, V, VI
System Description: Gravity/Conv.
Repair System Description: Same
Maintenance Agreement Required: ☐ Yes ☐ No

☒ House/Mod. Home No. Bedrooms 3
☐ Mobile Home No. Bathrooms 2
☐ Business No. Employees
☐ Other


☐ Slab ☒ Crawl Space ☐ Basement w/plumbing ☐ Basement wo/plumbing

Water Supply: ☒ Individual ☐ Public ☐ Community


Comments/Conditions: Keep septic 10' off PL, 5' off House, and stay out of Power easemet ROW
Install lines on contour

Comments/Conditions:

INITIAL SITE SKETCH

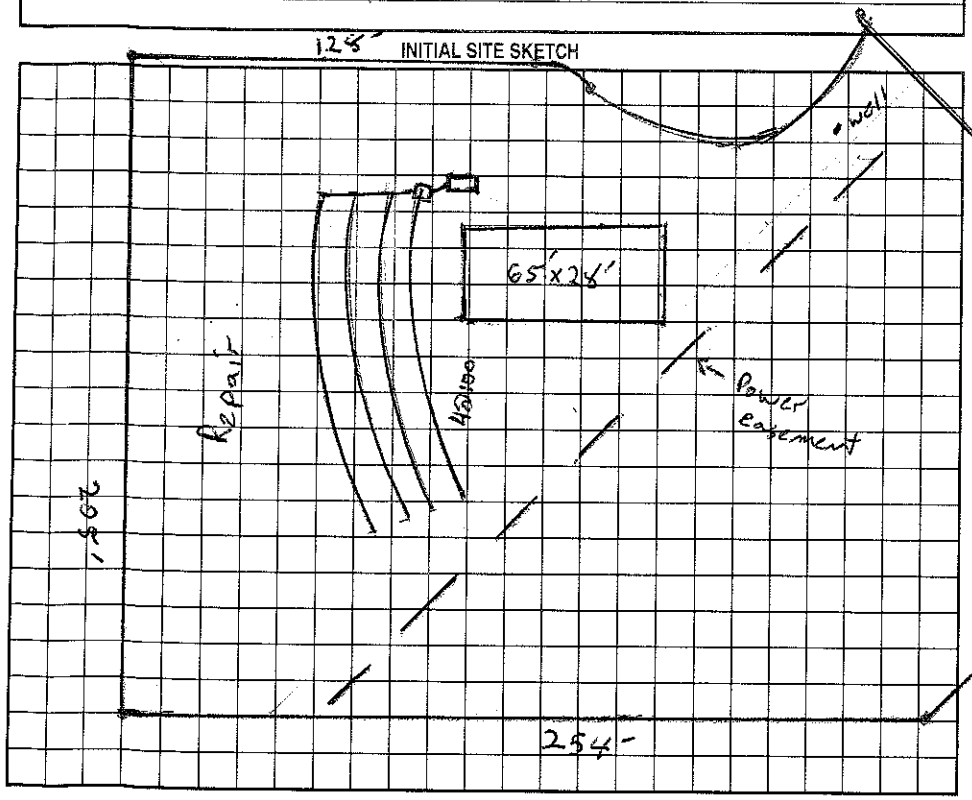

Scale 1=60 AS BUILT SKETCH

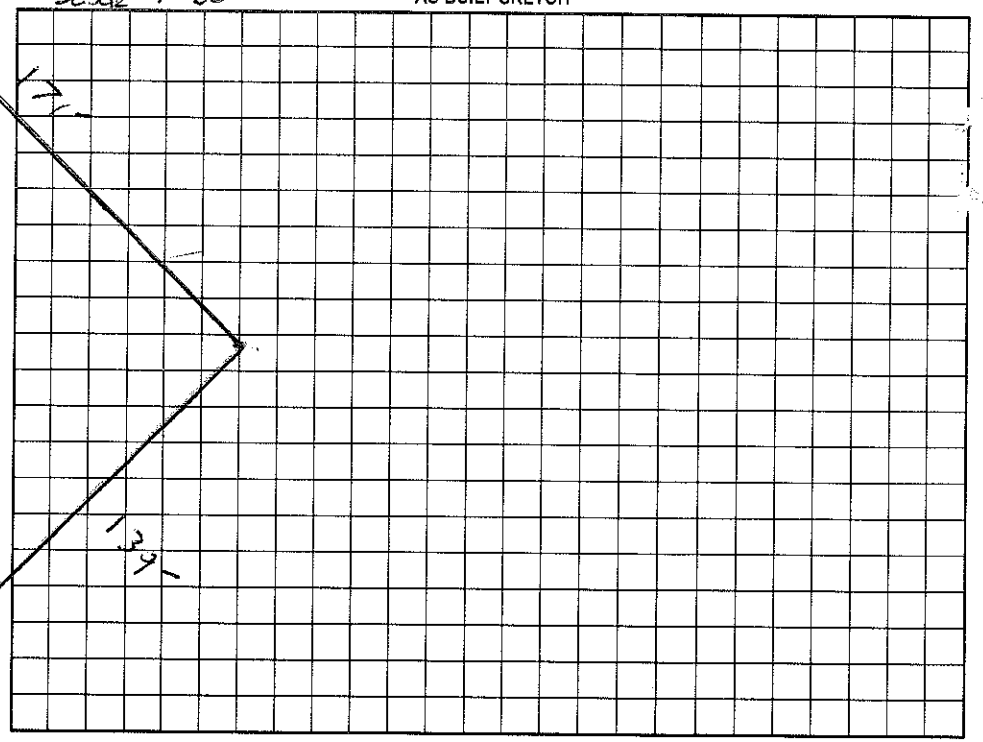

Permit can be suspended or revoked if any false information is supplied toward securing the permit/any unauthorized changes are made to the site/any unauthorized changes are made in the installation of the system. Improvement Permit with plat valid without expiration. Improvement Permit with site plan valid for sixty months. Authorization to Construct is valid for a period equal to that of Improvement Permit – not to exceed sixty months.

Signed: date 3/31/99 Installed by: Roman Septic

Improvement Permit by: Jeff Morgan date 3/24/99 Operation Permit by: Jeff Morgan date 5/12/99

Authorization to Construct by: Jeff Morgan date 3/24/99 Existing System Inspection by: date

HEALTH DEPT. COPY: WHITE OWNER COPY (FINAL): YELLOW OWNER COPY (INITIAL): PINK