IREDELL COUNTY HEALTH DEPARTMENT

STATESVILLE 704-878-5305 250.00 Paid MOORESVILLE 704-664-5281

IMPROVEMENT PERMIT / AUTHORIZATION TO CONSTRUCT / OPERATION PERMIT / EXISTING SYSTEM INSPECTION

PERMIT# 134549 PIN# 4740 31 2145 DATE

OWNER OR APPLICANT Brian + Elizabeth McClure PHONE: Business Home

ADDRESS 236 Ridge Creek Dr. Troutman NC 28166

LOCATION Perth, TR Clontz, TR Ridge Creek, at End on Rt.

SUBDIVISION Rocky Creek BLOCK / SECTION LOT 32 LOT AREA 1.39 Ac SITE CLASS. PS DESIGN FLOW 480 L.T.A.R. 0.3

Septic Tank: Exist. Gallons; STB Date

Pump Tank: Gallons; PT Date

Pump Make: Model Serial No.

Nitrification Field: No Fields 1 Square Feet 400 Linear Feet 133'

No Lines 1 Trench Width 36" Max Trench Bottom Depth 36" Gravel Depth 12" ☒ Gravity ☐ Pressure

☐ New System ☐ Repair ☒ Expansion System Type: I II III IV V VI

System Description: County Conventional

Repair System Description: 25% Reduction

Maintenance Agreement Required: ☐ Yes ☒ No

☒ House/Mod. Home No. Bedrooms 4

☐ Mobile Home No. Persons

☐ Business No. Employees

☐ Other


Water Supply: ☒ Individual ☐ Public ☐ Community

☐ Slab ☒ Crawl Space ☐ Basement w/plumbing ☐ Basement wo/plumbing


Comments/Conditions: Can use 100' of Accepted 25% Red.

Comments/Conditions:

Ridge Creek INITIAL SITE SKETCH

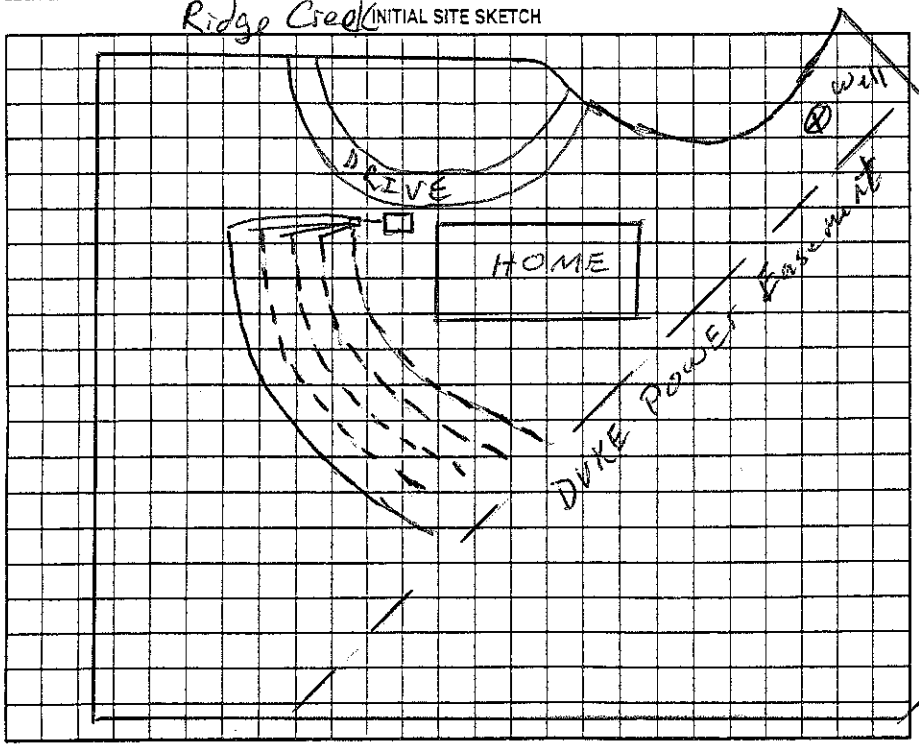

AS BUILT SKETCH

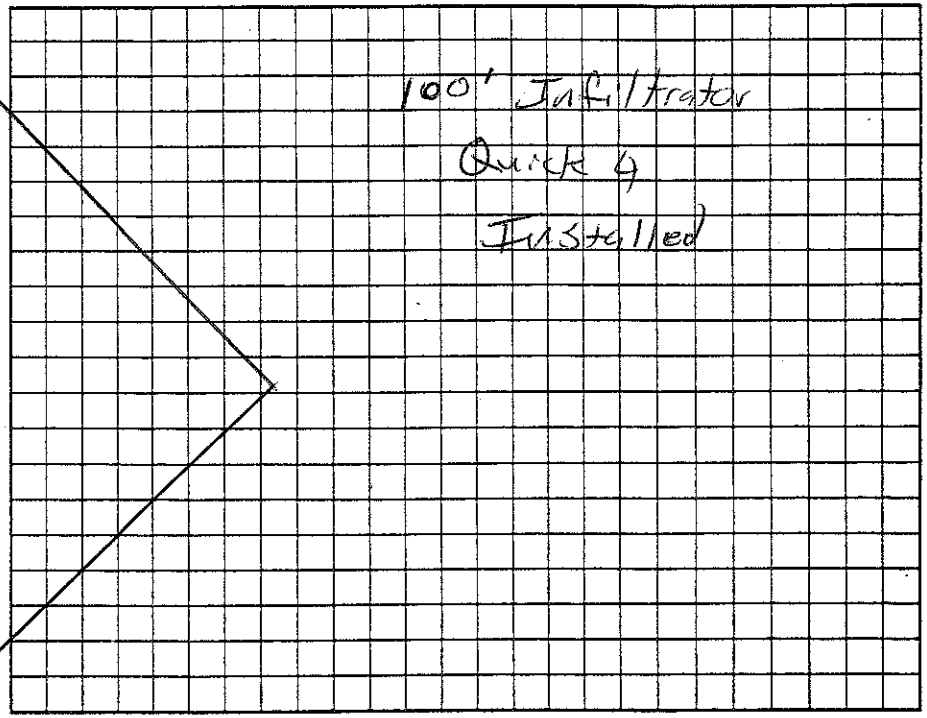

Permit can be suspended or revoked if any false information is supplied toward securing the permit/any unauthorized changes are made to the site/any unauthorized changes are made in the installation of the system. Improvement Permit with plat valid without expiration. ☐ Improvement Permit with site plan valid for sixty months ☒ Authorization to Construct is valid for a period equal to that of Improvement Permit – not to exceed sixty months.

Signed: date 4/6/06 Installed by:

Improvement Permit by: RS date 3/28/06 Operation Permit by: date

Authorization to Construct by: RS date 3/28/06 Existing System Inspection by: date

HEALTH DEPT COPY: WHITE OWNER COPY (FINAL): YELLOW OWNER COPY (INITIAL): PINK