IREDELL COUNTY HEALTH DEPARTMENT

STATESVILLE 704-878-5305 MOORESVILLE 704-664-5281

IMPROVEMENT PERMIT / AUTHORIZATION TO CONSTRUCT / OPERATION PERMIT / EXISTING SYSTEM INSPECTION

PERMIT# 151859/151845 PIN# 9740313397.000 DATE 8/18/08

OWNER OR APPLICANT CMH Homes PHONE: Business 865 380-3000 Home

ADDRESS PO Box 9790 Maryville TN 37801

LOCATION Perth E on N TR Clontz Hill TR Ridge Creek Dr at end on Left.

SUBDIVISION Rocky Creek Cove BLOCK / SECTION LOT 31 LOT AREA 5.1 SITE CLASS. PS DESIGN FLOW 480 L.T.A.R. 25

Septic Tank: 1000 Gallons: STB 760 Date 5-5

Pump Tank: Gallons: PT Date

Pump Make: Model Serial No.

Nitrification Field: No Fields 1 Square Feet Eq. 1920' Linear Feet 320'

No Lines 7 Trench Width 24" Max Trench Bottom Depth 30" * Gravel Depth NA

☑ New System ☐ Repair ☐ Expansion System Type: I II (III) IV V VI

System Description: Gravity 50% Reduction

Repair System Description: LPI 50% Reduction

Maintenance Agreement Required: ☐ Yes ☑ No

☑ House/Mod. Home ☐ Mobile Home ☐ Business ☐ Other

No. Bedrooms 4 No. Persons No. Employees


Water Supply: ☑ Individual ☐ Public ☐ Community

☑ Gravity ☐ Pressure ☐ Slab ☑ Crawl Space ☐ Basement w/plumbing ☐ Basement wo/plumbing


Comments/Conditions: Use large Dbox w/ 7 outlets for equal distribution. Smooth uneven top Ridge Area by knocking down high areas to blend with low areas

Comments/Conditions:

INITIAL SITE SKETCH 1" ≈ 40'

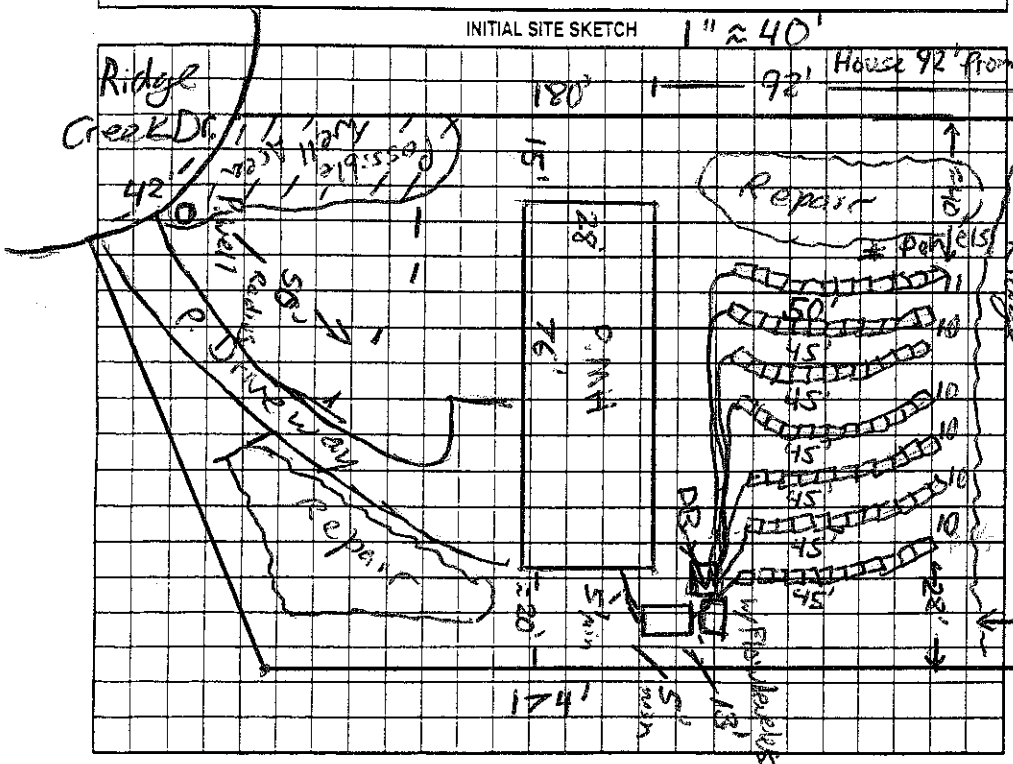

AS BUILT SKETCH

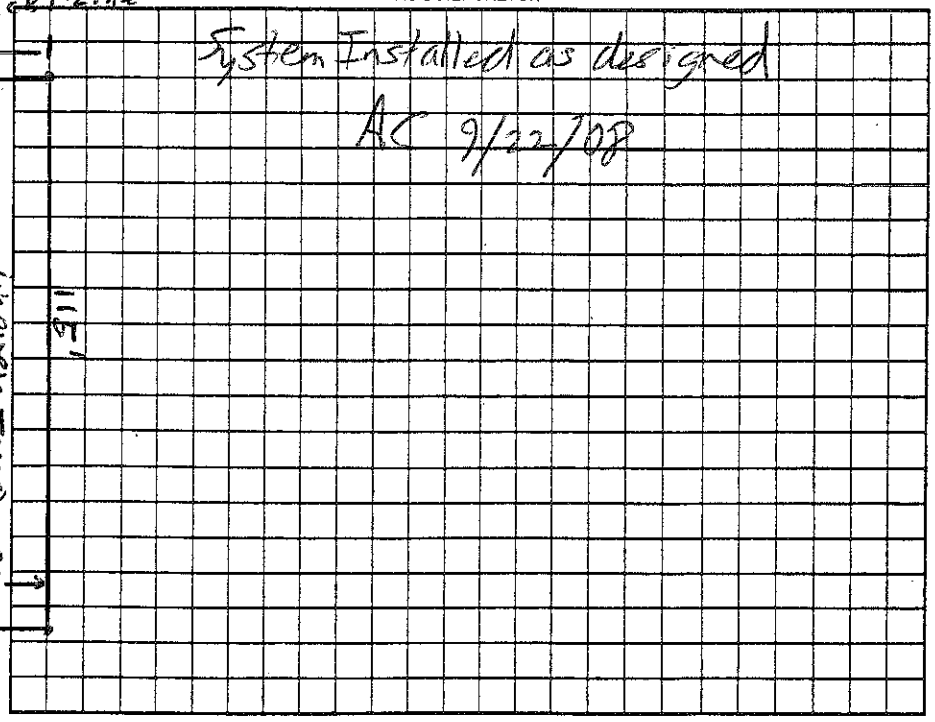

Permit can be suspended or revoked if any false information is supplied toward securing the permit/any unauthorized changes are made to the site/any unauthorized changes are made in the installation of the system. Improvement Permit with plat valid without expiration ☐ Improvement Permit with site plan valid for sixty months ☑ Authorization to Construct is valid for a period equal to that of Improvement Permit – not to exceed sixty months.

Signed: Eric M. Wood date 8-20-08 Installed by: Abee Grading

Improvement Permit by: Anthony Cohen Jr R.S. date 8/18/08 Operation Permit by: Anthony Cohen Jr date 9/22/08

Authorization to Construct by: Anthony Cohen Jr R.S. date 8/18/08 Existing System Inspection by: date

HEALTH DEPT. COPY: WHITE OWNER COPY (FINAL): YELLOW OWNER COPY (INITIAL): PINK