IREDELL COUNTY HEALTH DEPARTMENT

STATESVILLE 704-878-5305 MOORESVILLE 704-664-5281

(4.00)

IMPROVEMENT PERMIT / AUTHORIZATION TO CONSTRUCT / OPERATION PERMIT / EXISTING SYSTEM INSPECTION

PERMIT# 05103 PIN# 4740315361 DATE 5/13/99

OWNER OR CONTRACTOR A# Inc. PHONE: Business 704-855-1999 Home

ADDRESS 420 Auction Dr., Salisbury NC 28144

LOCATION Perth, TL Clontz Hill, TR Ridge Creek, Attend

SUBDIVISION Rocky ~~Acres~~ Cove/ BLOCK / SECTION LOT 188 LOT AREA 1.92 AC SITE CLASS. PS DESIGN FLOW 360 L.T.A.R. .3

Septic Tank: 1000 Gallons; STB 525 Date 3/4/99

Pump Tank: 1200 Gallons; PT 47 Date 3/11/99

Pump Make: Model Serial No.

Nitrification Field: No Fields 1 Square Feet 900 Linear Feet 300

No Lines 5@60 Trench Width 36" Max Trench Bottom Depth 36" Gravel Depth N/A

☒ New System ☐ Repair System Type: I, II, (III), IV, V, VI

System Description: Pump / Chamber

Repair System Description: Chamber / Panel

Maintenance Agreement Required: ☐ Yes ☐ No

☒ House/Mod. Home No. Bedrooms 3

☐ Mobile Home No. Bathrooms 2

☐ Business No. Employees

☐ Other


☐ Slab ☐ Crawl Space ☐ Basement w/plumbing ☐ Basement wo/plumbing

Water Supply: ☒ Individual ☐ Public ☐ Community

Comments/Conditions:

Comments/Conditions: JAMES JAMES PRESSURE

INITIAL SITE SKETCH 1"=100'

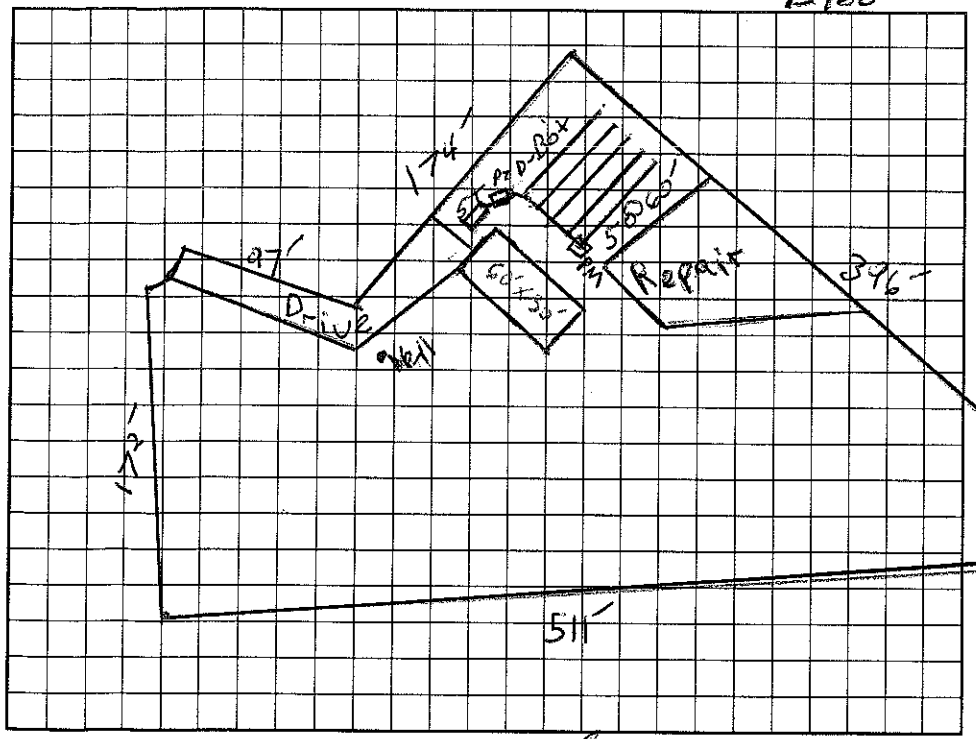

AS BUILT SKETCH

Permit can be suspended or revoked if any false information is supplied toward securing the permit/any unauthorized changes are made to the site/any unauthorized changes are made in the installation of the system. Improvement Permit with plat valid without expiration. Improvement Permit with site plan valid for sixty months. Authorization to Construct is valid for a period equal to that of Improvement Permit – not to exceed sixty months.

Signed: date 5-13-99 Installed by: Ronda Scott

Improvement Permit by: Jeff Morgan date 5/12/99 Operation Permit by: Jeff Morgan date 6-21-99

Authorization to Construct by: Jeff Morgan date 5/12/99 Existing System Inspection by: date

HEALTH DEPT. COPY: WHITE OWNER COPY (FINAL): YELLOW OWNER COPY (INITIAL): PINK