IREDELL COUNTY HEALTH DEPARTMENT

STATESVILLE 704-878-5305 MOORESVILLE 704-664-5281

IMPROVEMENT PERMIT / AUTHORIZATION TO CONSTRUCT / OPERATION PERMIT / EXISTING SYSTEM INSPECTION

PERMIT# 22132 PIN# 3HC - 25 4740 34 6709 DATE 3/9/98

OWNER OR CONTRACTOR Walter C Whitmire PHONE: Business _____ Home 528-4772

ADDRESS 273 Lyle Rd. Troutman NC. 28166

LOCATION end of Lyle Rd. on to drive house on (L)

SUBDIVISION _____ BLOCK / SECTION _____ LOT _____ LOT AREA 1.5Ac SITE CLASS. PS DESIGN FLOW 360 L.T.A.R. .3

Septic Tank: 1000 Gallons; STB 794 Date 10/27/98
Pump Tank: 1000 Gallons; PT 27 Date 2/9/98
Pump Make: HYDROMATIC Model SK-50A Serial No. 2/98
Nitrification Field: No Fields 1 Square Feet 1599 Linear Feet 533
No Lines 4 Trench Width 36" Max Trench Bottom Depth 36" Gravel Depth 12"

[X] New System [ ] Repair System Type: I, II, [III] IV, V, VI
System Description: Pres Man - Conventional
Repair System Description: Same
Maintenance Agreement Required: [ ] Yes [X] No

[X] House/Mod. Home [ ] Mobile Home [ ] Business [ ] Other
No. Bedrooms 3 No. Bathrooms 2 No. Employees ____


[ ] Slab [ ] Crawl Space [X] Basement w/plumbing [ ] Basement wo/plumbing

Water Supply: [X] Individual [ ] Public [ ] Community

Comments:/Conditions: [1] WELL

Comments:/Conditions:

INITIAL SITE SKETCH

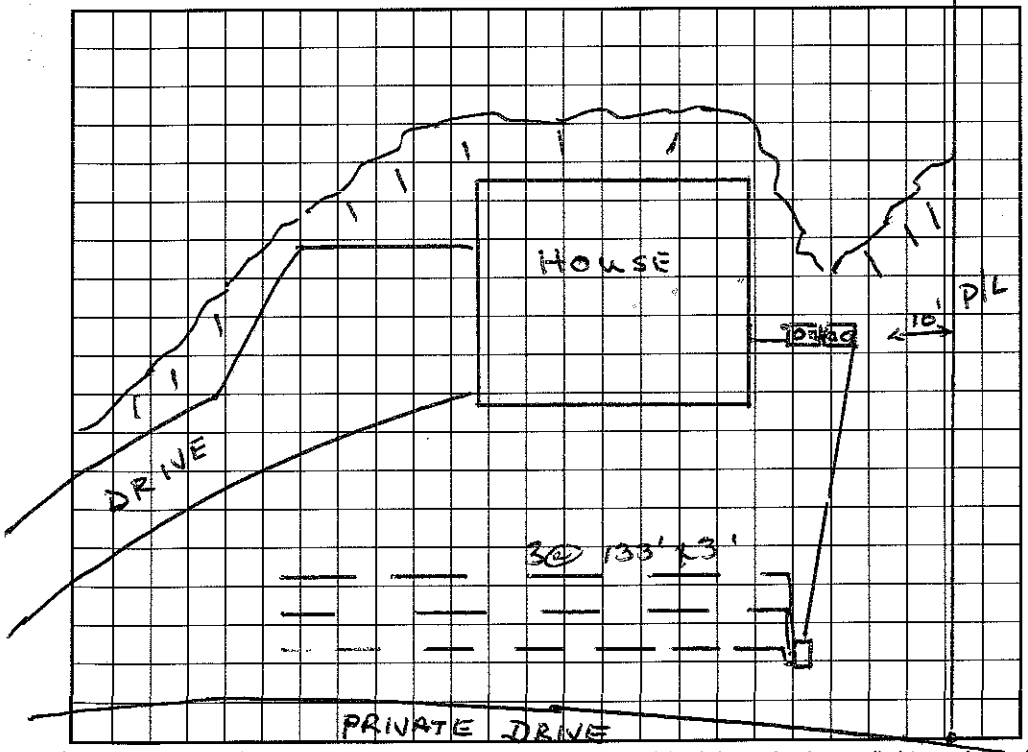

AS BUILT SKETCH

I understand that this permit can be suspended or revoked if any false information is supplied toward securing the permit/any unauthorized changes are made to the site/any unauthorized changes are made in the installation of the system. Improvement Permit with plat valid without expiration. Improvement Permit with site plan valid for sixty months. Authorization to Construct is valid for a period equal to that of Improvement Permit – not to exceed sixty months.

Signed: X date _____

Improvement Permit by: Wesley Sparks RS. date 3/16/98

Authorization to Construct by: Wesley Sparks RS. date 3/16/98

Installed by: Tim Simmons

Operation Permit by: Jeff Morgan date 12/2/99

Existing System Inspection by: _____ date _____

HEALTH DEPT. COPY: WHITE INSPECTION COPY (FINAL): GREEN OWNER COPY (FINAL): YELLOW INSPECTION COPY (INITIAL): PINK OWNER COPY (INITIAL): GOLD