IREDELL COUNTY HEALTH DEPARTMENT

STATESVILLE 704-878-5305 MOORESVILLE 704-664-5281

IMPROVEMENT PERMIT / AUTHORIZATION TO CONSTRUCT / OPERATION PERMIT / EXISTING SYSTEM INSPECTION

$125.00 Paid 2:30

PERMIT# 91264 PIN# ~~4740 20 3493~~ 4740401844 DATE 3/29/01

OWNER OR CONTRACTOR AH Inc PHONE: Business 704-636-2765 Home

ADDRESS 2310 S. Main St Salisbury NC 28147

LOCATION Cloantz Hill, R Ridge Crk, R Wiltshire Loganthur Crk on RT

SUBDIVISION Wiltshire Crk BLOCK / SECTION LOT 29 LOT AREA 0.82 AC SITE CLASS. PS DESIGN FLOW 360 L.T.A.R. 0.5

Septic Tank: 1000 Gallons; STB 525 Date 1/30/01
Pump Tank: Gallons; PT Date
Pump Make: Model Serial No.
Nitrification Field: No Fields 1 Square Feet 900 Linear Feet 300'
No Lines 4 Trench Width 36" Max Trench Bottom Depth 24" Gravel Depth —

☒ New System ☐ Repair System Type: I, II, (III), IV, V, VI
System Description: Gravity 25% Reduction
Repair System Description: Pump 25% Reduction
Maintenance Agreement Required: ☐ Yes ☐ No

☒ House/Mod. Home No. Bedrooms 3
☐ Mobile Home No. Bathrooms 2
☐ Business No. Employees
☐ Other


☐ Slab ☒ Crawl Space ☐ Basement w/plumbing ☐ Basement wo/plumbing

Water Supply: ☒ Individual ☐ Public ☐ Community

Comments:/Conditions: Install Lines on Contour – Keep Well 50' Minimum from septic system
1:50 scale


Comments:/Conditions:

INITIAL SITE SKETCH

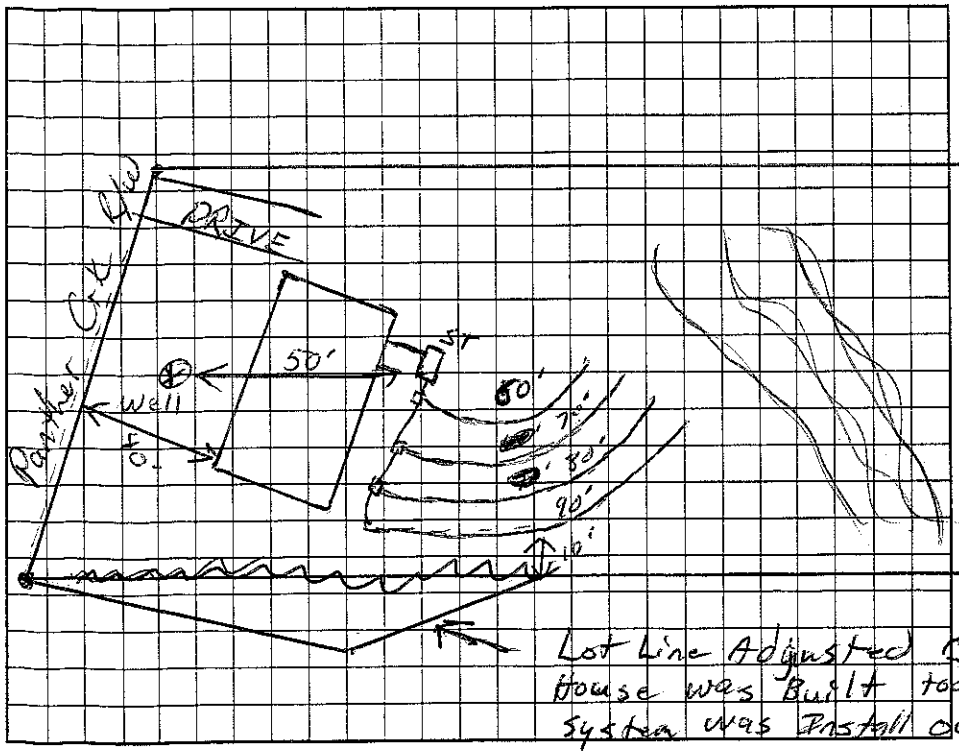

Lot Line Adjusted Because House was Built to close to the original line and System was Installed over the original line (See Attached Plat)

AS BUILT SKETCH

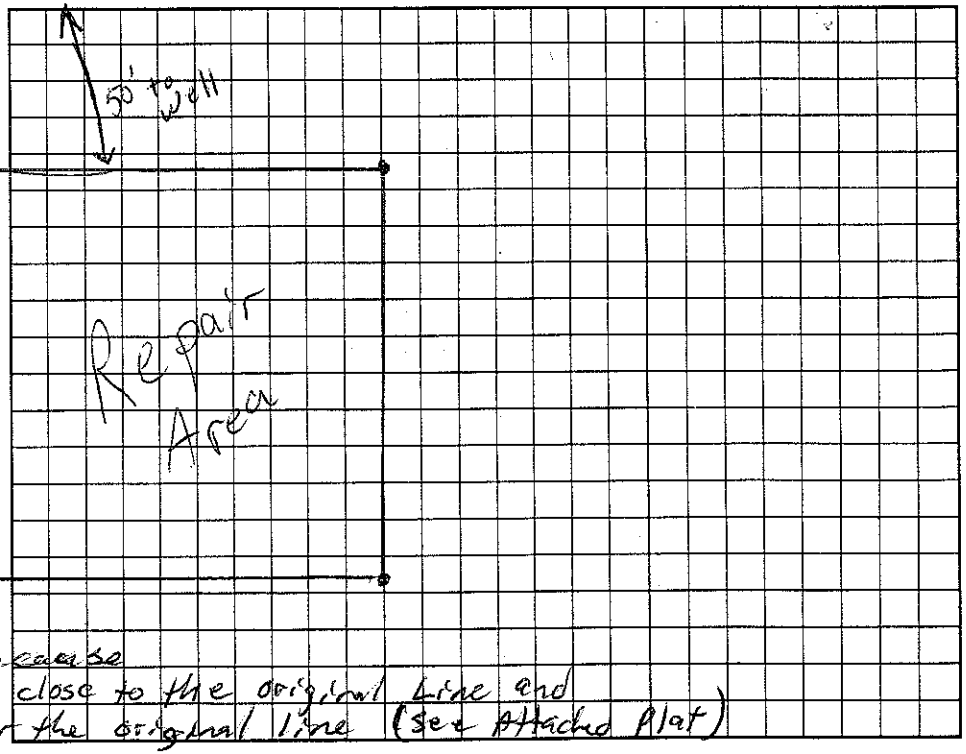

Permit can be suspended or revoked if any false information is supplied toward securing the permit/any unauthorized changes are made to the site/any unauthorized changes are made in the installation of the system. Improvement Permit with plat valid without expiration. Improvement Permit with site plan valid for sixty months. Authorization to Construct is valid for a period equal to that of Improvement Permit – not to exceed sixty months.

Signed: date 4/4/01 Installed by: Rowan Septic

Improvement Permit by: RSF date 3/29/01 Operation Permit by: RSF date 6/22/01

Authorization to Construct by: RSF date 3/29/01 Existing System Inspection by: date

HEALTH DEPT. COPY: WHITE OWNER COPY (FINAL): YELLOW OWNER COPY (INITIAL): PINK