IREDELL COUNTY HEALTH DEPARTMENT

STATE 704-878-5305 MOORESVILLE 704-664-5281

IMPROVEMENT PERMIT / AUTHORIZATION TO CONSTRUCT / OPERATION PERMIT / EXISTING SYSTEM INSPECTION

PERMIT# 133475 PIN# 4740 40 5566 DATE 2/3/06

OWNER OR CONTRACTOR Corinthian Bldrs PHONE: Business _____ Home _____

ADDRESS PO Box 3241 Mooresville NC 28115

LOCATION 115N TL Flowerhouse TR Farmdale, TL Grafton, at End

SUBDIVISION Carlyle Farms BLOCK / SECTION 3 LOT 31 LOT AREA 1.014ac SITE CLASS. PS DESIGN FLOW 360 L.T.A.R. 0.3

Septic Tank: 1000 Gallons; STB 786 Date _____

Pump Tank: _____ Gallons; PT _____ Date _____

Pump Make: _____ Model _____ Serial No. _____

Nitrification Field: No Fields 1 Square Feet 1200 Linear Feet 400

No Lines 3 Trench Width 36" Max Trench Bottom Depth 36" Gravel Depth 12"

☒ New System ☐ Repair System Type: I, II, III, IV, V, VI

System Description: Gravity Conventional

Repair System Description: Same

Maintenance Agreement Required: ☐ Yes ☒ No

☒ House/Mod. Home No. Bedrooms 3

☐ Mobile Home No. Bathrooms _____

☐ Business No. Employees _____


☐ Other _____

☐ Slab ☒ Crawl Space ☐ Basement w/plumbing ☐ Basement wo/plumbing

Water Supply: ☒ Individual ☐ Public ☐ Community


Comments:/Conditions: 1"=50'

INITIAL SITE SKETCH

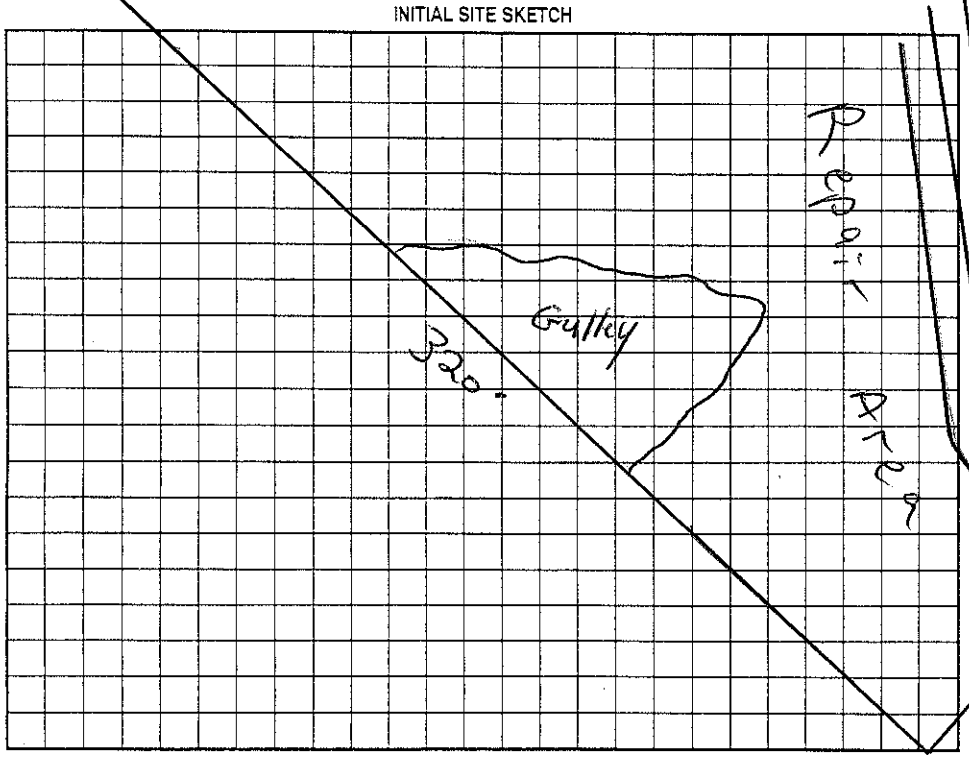

Comments:/Conditions:

AS BUILT SKETCH

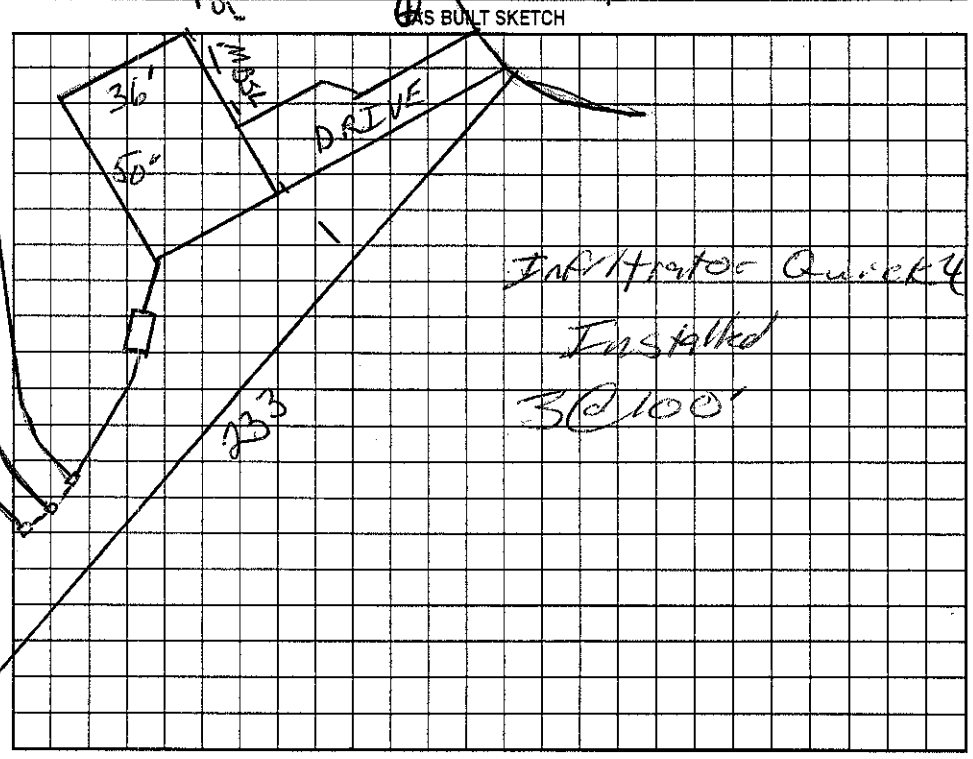

Permit can be suspended or revoked if any false information is supplied toward securing the permit/any unauthorized changes are made to the site/any unauthorized changes are made in the installation of the system. Improvement Permit with plat valid without expiration. Improvement Permit with site plan valid for sixty months. Authorization to Construct is valid for a period equal to that of Improvement Permit – not to exceed sixty months.

Signed: _____ date 2-7-06 Installed by: Corinthian Bldrs

Improvement Permit by: _____ RS date 2/3/06 Operation Permit by: _____ RS date 4/18/06

Authorization to Construct by: _____ RS date 2/3/06 Existing System Inspection by: _____ date _____

HEALTH DEPT. COPY: WHITE OWNER COPY (FINAL): YELLOW OWNER COPY (INITIAL): PINK